




DATE \_\_\_\_\_

TOWN OF LEXINGTON — BOARD OF PUBLIC WORKS  
SEWER DIVISION

Sketch of Service Here

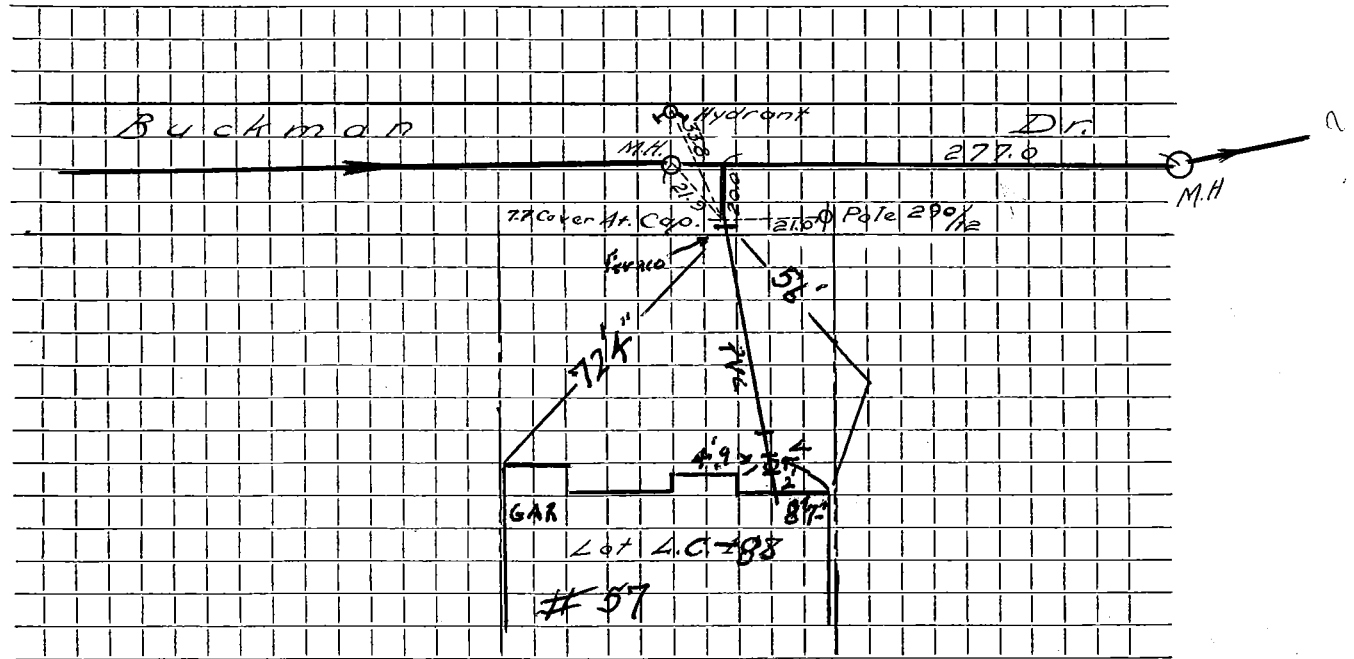

Connection made in ..... Street.

Work completed 9/2/10..... J. McLaughlin.....

Remarks: .....  
.....  
.....