

Name Charles Lermond

Service No. 200

Address 102 Burlington Street

Location

Kind of Pipe Permit #A 55

Size

Size of Main

~~Repair - Renewal~~ - New Service Valeri Const. Co.

Location


DEC 31 1965

Date		Material	Amount	Total	Date		Amount
1965	4'	6" Transite pipe @6.00		24.00	10-22-65	Cyprus P	24.00
10-30-65	85'	6" Transite pipe					

DATE \_\_\_\_\_

**TOWN OF LEXINGTON — BOARD OF PUBLIC WORKS**  
**SEWER DIVISION**

Sketch of Service Here **102**

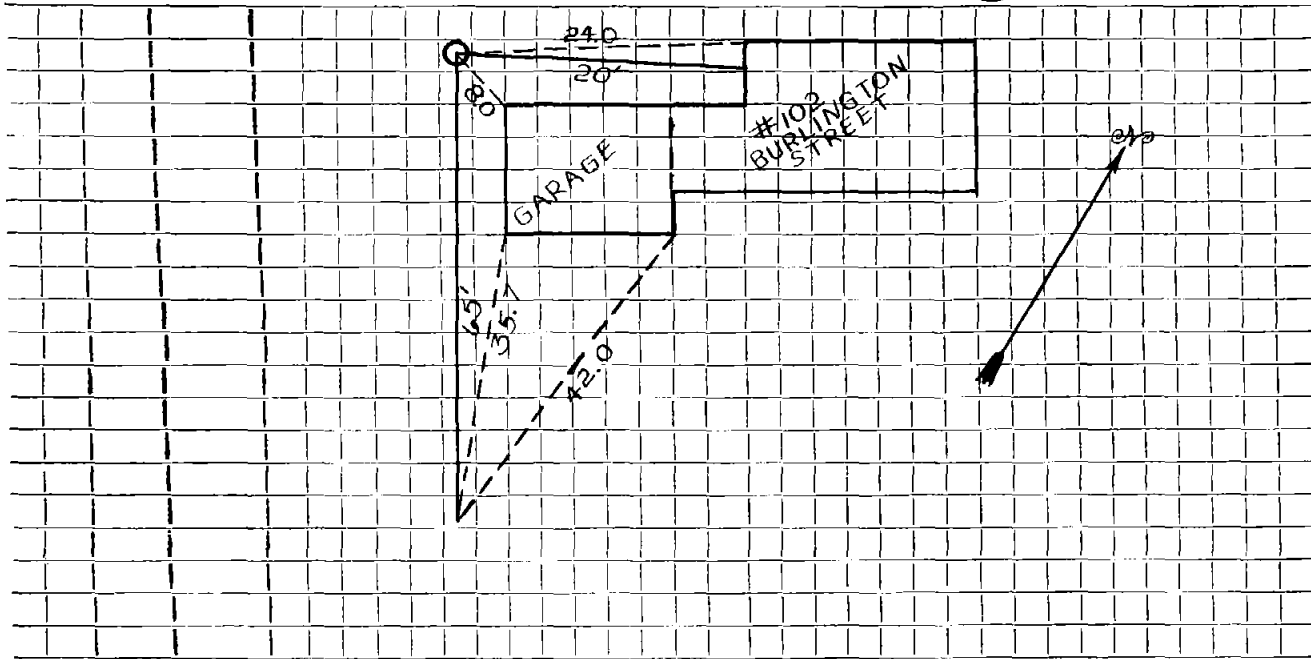

Connection made in ..... Street. Work completed .....

Remarks: .....  
.....  
.....