

Name **8**

Service No.

Address **105 BURLINGTON**

Location

Kind of Pipe

Size

Size of Main

Repair—Renewal—New Service

Location


Date	Material	Amount	Total	Date		Amount
7/27/78	50'-6" ACP; 16'-4" CI					
				1965	26' 6" Transite	
				2-26-97	Repair was made	
				2-24-97	Respond + Measure	

DATE _____

TOWN OF LEXINGTON — BOARD OF PUBLIC WORKS
SEWER DIVISION

Sketch of Service Here

105

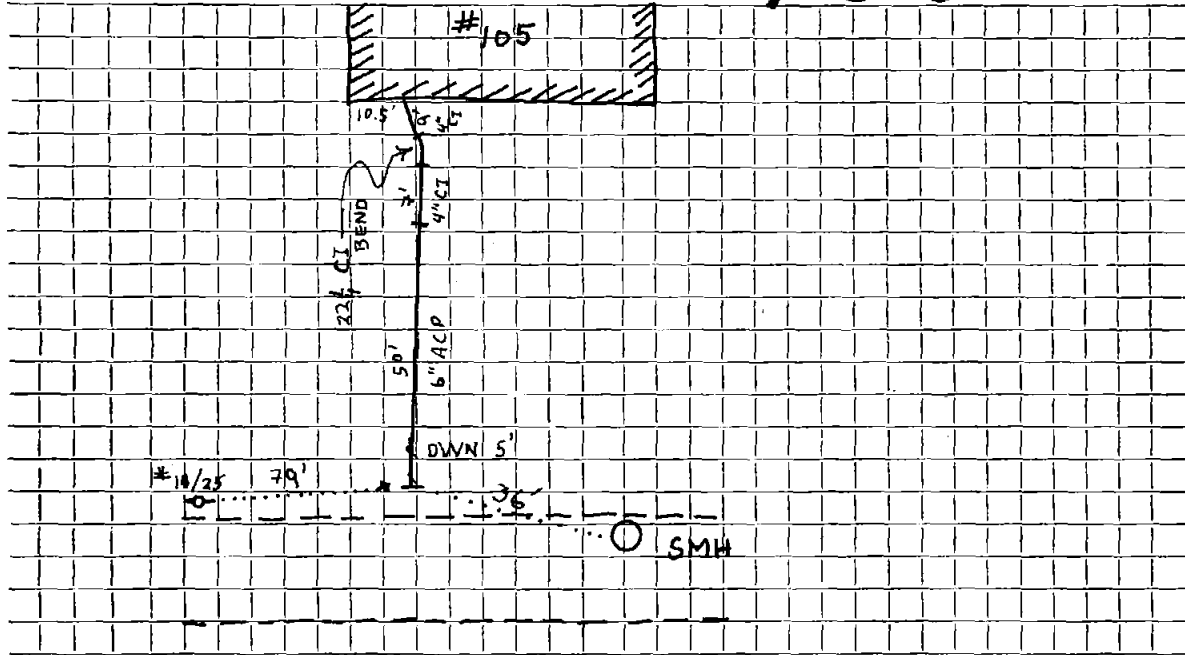

Connection made in Street. Work completed

Remarks:

.....
.....