

Name Mrs. Margaret K. Nelson

Service No. 198

Address 109 Burlington Street

Location

Kind of Pipe Permit #A 53

Size

Size of Main

~~Repair/Renewal~~ New Service Suburnaite Cesspool

Location


DEC 31 1965

Date		Material	Amount	Total	Date		Amount
1965	26'	6" Transite pipe	6.00	156.00	10-20-65	<i>Deposit</i>	156.00
10-30-65	70'	6" Transite pipe					
					1965		
					26' 6" Transite		

DATE _____

TOWN OF LEXINGTON — BOARD OF PUBLIC WORKS
SEWER DIVISION

Sketch of Service Here **109**

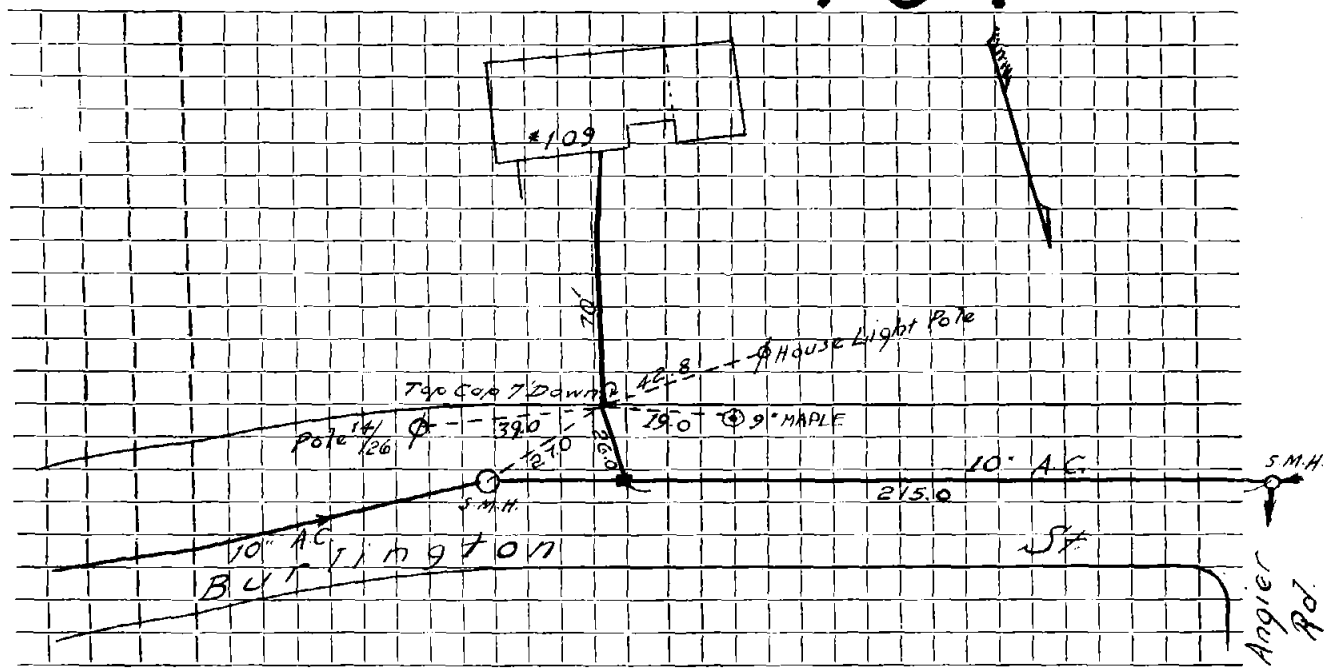

Connection made in Street. Work completed

Remarks:
.....
.....