

Name Richard W. Chase

Service No. 104

Address 111 Burlington Street

Location

Kind of Pipe

Size

Size of Main

Repair—Renewal—New Service

Lexington Sewerage #A392

Location

OCT 3 1966

Date

Material

Amount

Total

Date

Amount

~~1965~~ 30' 6" Transite pipe @6.00

180.00

8-8-66

Deposit

180.00

8/24/66 53' 6" Transite

22.15 4" Cast iron

1965


30' 6" Transite

DATE _____

TOWN OF LEXINGTON — BOARD OF PUBLIC WORKS

SEWER DIVISION

Sketch of Service Here **///**

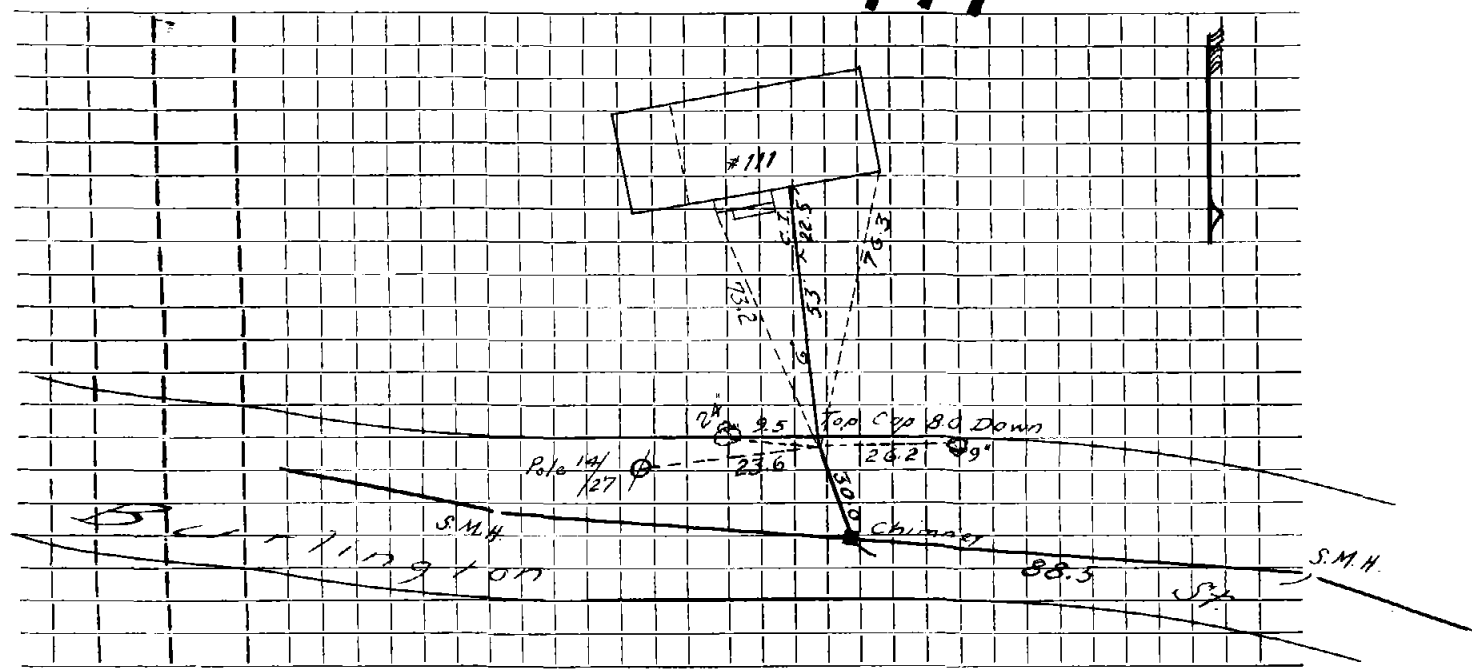

Connection made in Street. Work completed

Remarks:
.....
.....