

Name Dr. John Murtaugh

Service No. 50

Address 114 Burlington Street

Location

Kind of Pipe

Size

Size of Main

~~Repair~~ ~~Renewal~~ ~~New Service~~ Permit #A249
Suburbanite Cesspool Service

Location JUN 23 1966

Date	Material	Amount	Total	Date	Amount
------	----------	--------	-------	------	--------

1965	6' 6" Transite pipe @6.00		36.00	4-25-66	Deposit	36.00
-----------------	---------------------------	--	-------	---------	---------	-------

5-12-66	40' 6" Transite pipe					
---------	----------------------	--	--	--	--	--


	10' Cast Iron Pipe			1965		
--	--------------------	--	--	------	--	--

6' 6" Transite

DATE _____

TOWN OF LEXINGTON — BOARD OF PUBLIC WORKS
SEWER DIVISION

Sketch of Service Here **114**

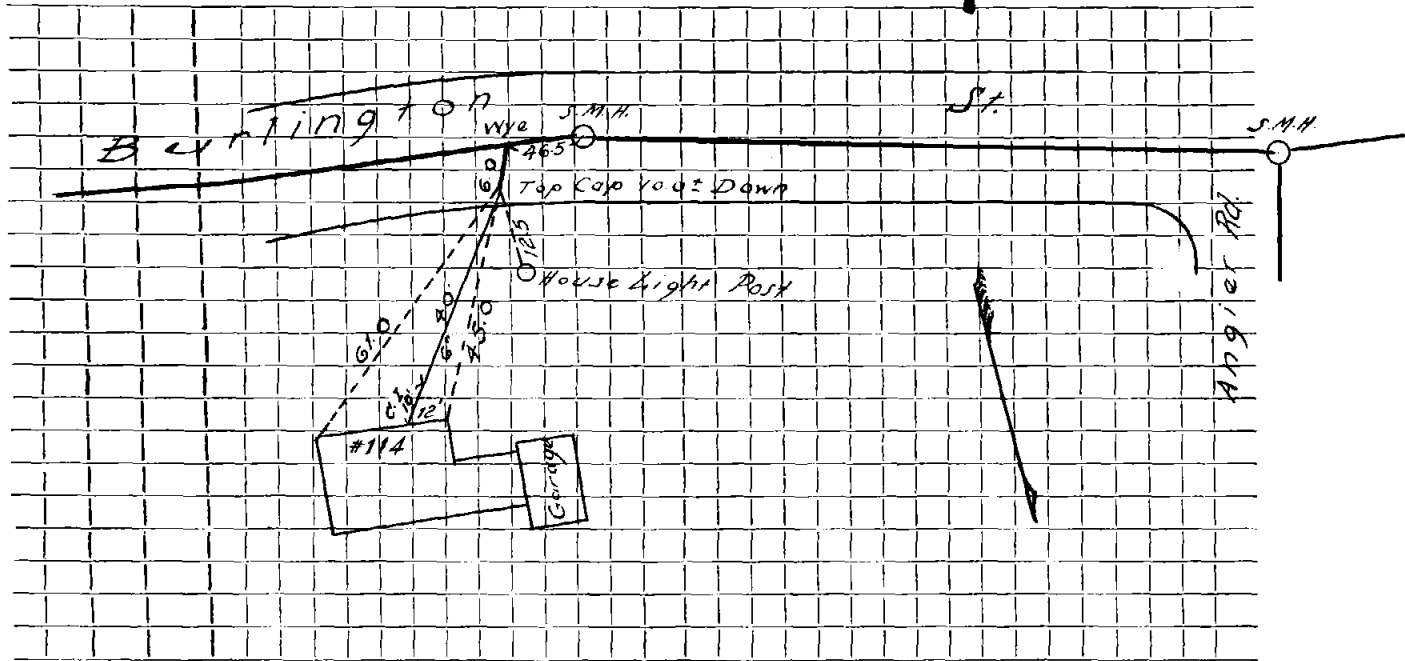

Connection made in Street. Work completed

Remarks:
.....
.....