

Name **BRIAN COREY**

Service No.

Address **#117 BURLINGTON STREET**

Location

Kind of Pipe

Size

Size of Main

Repair—Renewal—**New Service**

PERMIT NO. 0881 - ARLEX OIL COMPANY

Location

SEPTIC
ABANDONMENT

Date

Material

Amount

Total

Date

Amount

10/9 96


8" ϕ PVC SEWER

6" ϕ PVC SERVICE

DATE 17 OCTOBER 1996

TOWN OF LEXINGTON — BOARD OF PUBLIC WORKS

SEWER DIVISION

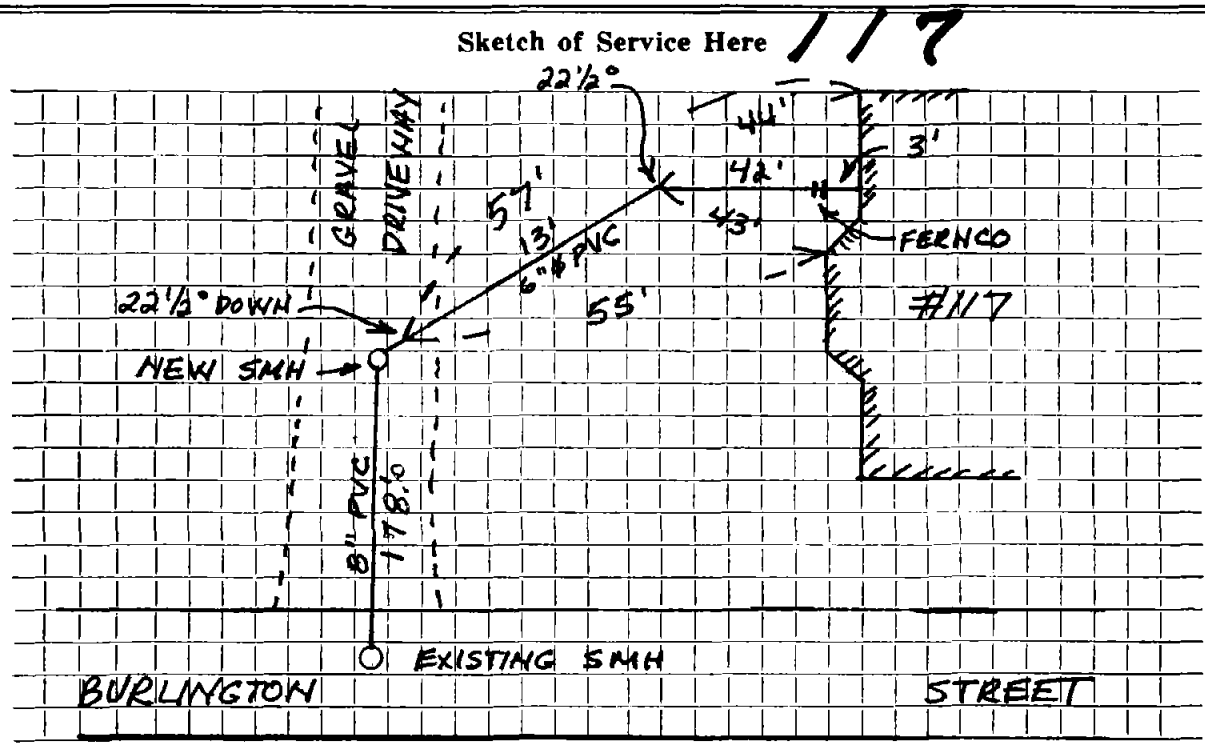

Connection made in BURLINGTON STREET Street.

Work completed ARLEX OIL COMPANY.....

Remarks: