


DATE 29 OCTOBER 1996

TOWN OF LEXINGTON — BOARD OF PUBLIC WORKS
SEWER DIVISION

Sketch of Service Here

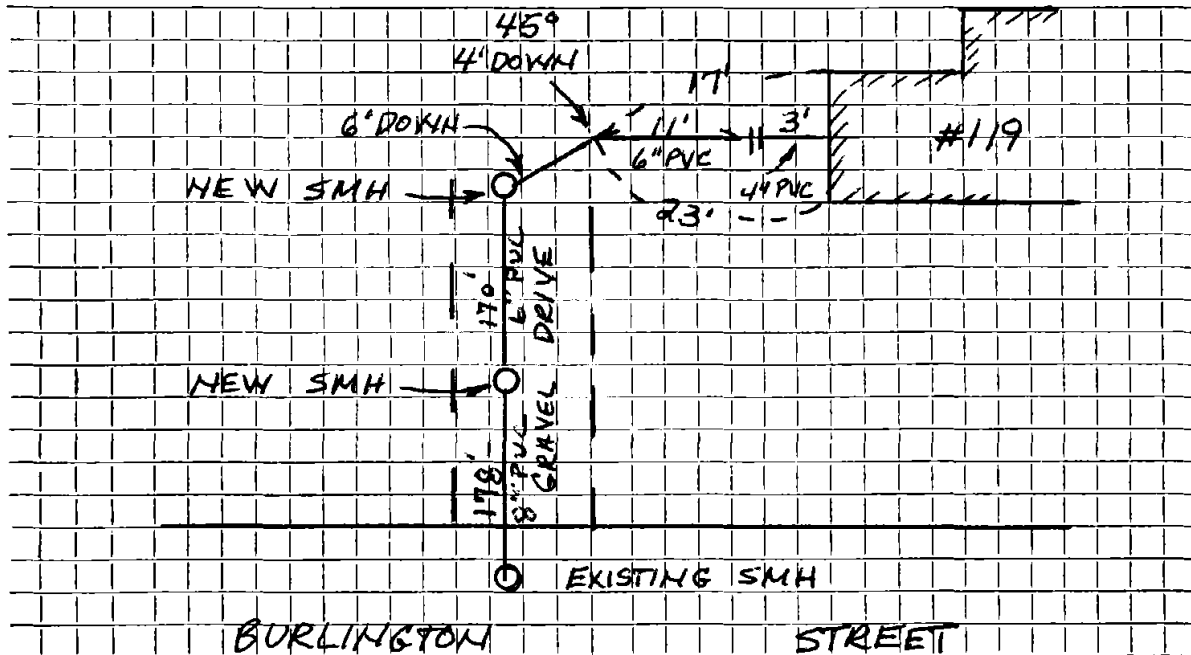

Connection made in BURLINGTON STREET Street.

Work completed ARLEX OIL COMPANY.....

Remarks: