

Name Ed Sahatjian

Service No. 127

Address 124 Burlington Street

Location

Kind of Pipe Transite

Size 6"

Size of Main

~~Repair~~ ~~Renewal~~ ~~New Service~~ W.O. #4441 Lucente Permit #2770.

Location MAR 15 1976


Date	Material	Amount	Total	Date	Amount
1965	7' 6" Transite pipe @6.00		42.00	11-3-75	236.00
12/5/75	Labor	\$120.36		4-30-76	38.38
	10 % O.H.	12.04	\$132.40		258.38
1	10' Transite Pipe @1.48/Ft.		14.80	1965	
1	5' " " @1.56/Ft.		7.80	7' 6" Transite	
1	2' " Nipple		5.39		
1	1' " Nipple		2.44		
1	90° Elbow		5.48		
1	6" Cap		3.75		
1	Ton Cold Patch		13.75		
1	10 x 6 Saddle		15.07		
1	Hr. Trucking		3.00		
1	Hr. Pick up		1.50	11/18/75 55'	6" Transite pipe
1	Hr. Loader		4.00	10'	4" C. I. Pipe
2	Hrs. Town Shovel @6.50		13.00		
1	Patch 7'x8' x2"		36.00		
			\$258.38		

DATE _____

TOWN OF LEXINGTON — BOARD OF PUBLIC WORKS

SEWER DIVISION

Sketch of Service Here **124**

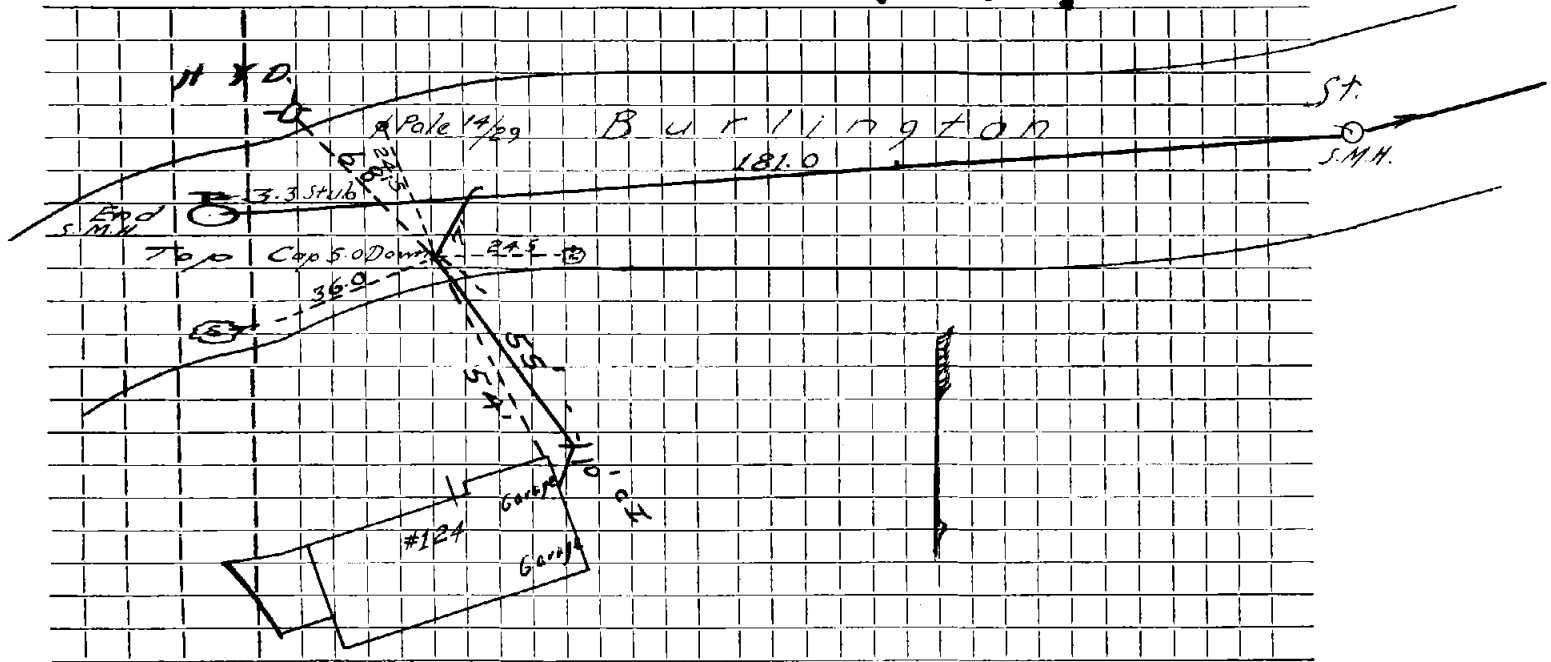

Connection made in Street. Work completed

Remarks:
.....
.....