

Name William P. Davis

Service No. 192

Address #125 BURLINGTON ST.

Location

Kind of Pipe David Eagle - Permit #162

Size

Size of Main

~~Repair-Renewal~~ - New Service W.O. #9385

Location FEB 15 1965


Date	Material	Amount	Total	Date	Amount
12-2-64	Labor	38 76		11-18-64	Deposit 150 00
	10% O.H.	3 88	42 64	2-15-65	Retund 42 00
	24' 6" Transite pipe @ .82		19 68		168 00
	1 11 1/2 Bend		4 09		
	1 90° Elbow		4 09		
	21 x 3 Patch		21 00		
	1 Hr Town Shovel		6 50		
	2 Hr Town Truck @ 3.00		6 00		
	1 Hr Loader		4 00		
			108 00		
12-16-64	90' 6" Transite pipe				

DATE _____

TOWN OF LEXINGTON — BOARD OF PUBLIC WORKS
SEWER DIVISION

Sketch of Service Here

125

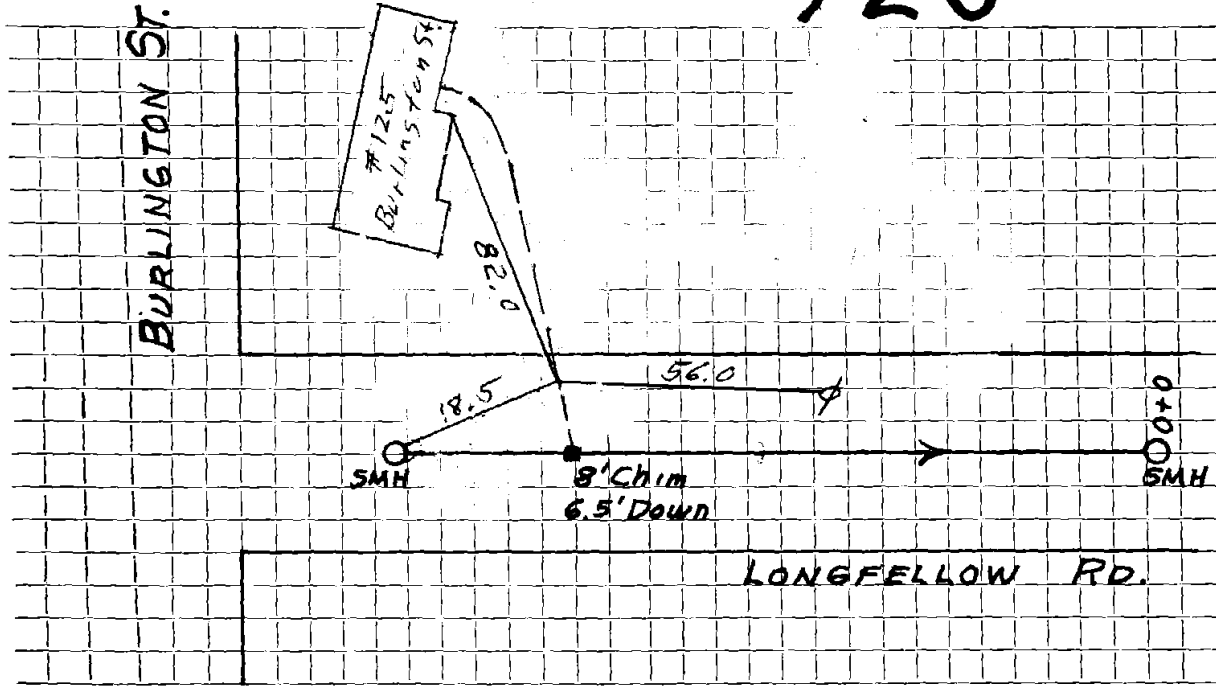

Connection made in Street. Work completed

Remarks:
.....
.....