
Name					Service No.	
Address	131 BUR	LINGTON	ST			
	15	Now		Location		
Kind of P	ipe 2	Now HAWTHO	A Strot	n d	Size of Main	<del></del>
Repair—Re	enewal—New Service				Location	
Date	Material	Amount	Total	Date		Amount
	2-9-	-05				
		<del>-</del>		<del> </del>		
		<del>                                     </del>				
			<del></del>			
						<del></del>

_	•	TE				
_	-		 	 	 _	

## TOWN OF LEXINGTON — BOARD OF PUBLIC WORKS SEWER DIVISION

## Sketch of Service Here

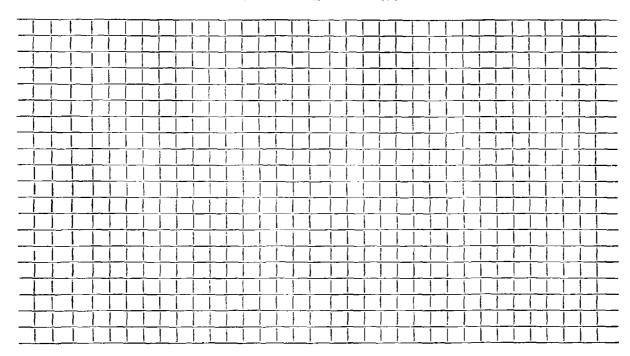

Connection made in	Street.	Work completed	
Remarks:	· · · · · · · · · · · · · · · · · · ·		
		.,,,,,,,,,,,,,,,,,,,,,,,,,,,,,,,,,,,,,,	