


DATE APRIL 1986

TOWN OF LEXINGTON — BOARD OF PUBLIC WORKS
SEWER DIVISION

Sketch of Service Here **133**

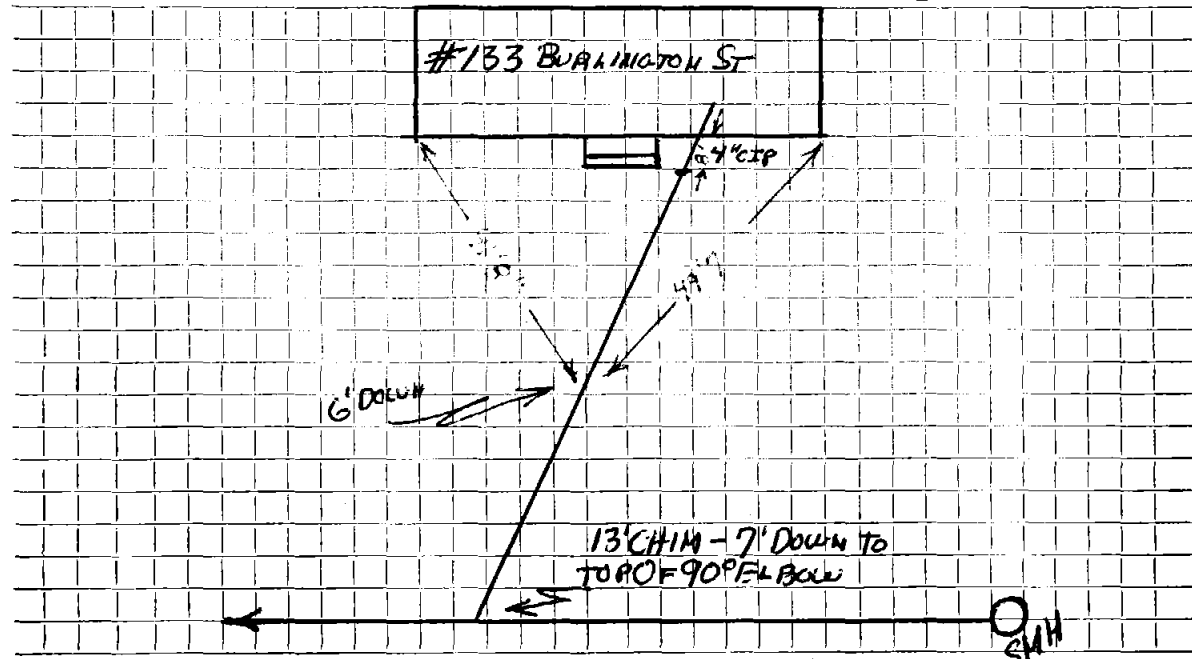

Connection made in BURLINGTON ST Street.

Work completed APRIL 18, 1986

Remarks:

.....

.....