


TOWN OF LEXINGTON — BOARD OF PUBLIC WORKS
SEWER DIVISION

134 Sketch of Service Here

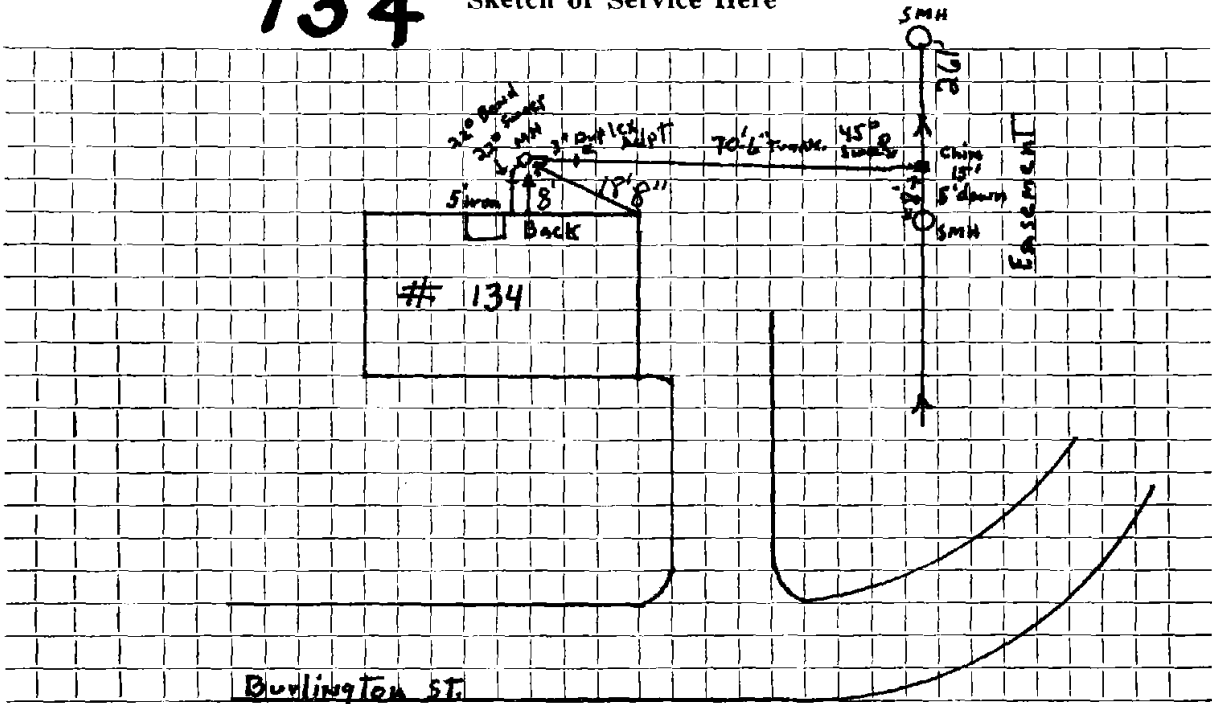

Connection made in Street. Work completed

Remarks:
.....
.....