

Name

Service No. 1501

Address 137 BURLINGTON ST

Location

Kind of Pipe PVC

Size 6"

Size of Main

Repair Renewal New Service

Location

Date

Material

Amount

Total

Date

Amount


5-18 01 82' 6" PVC

1 WYE

1 45° SWEEP

DATE _____

TOWN OF LEXINGTON — BOARD OF PUBLIC WORKS
SEWER DIVISION

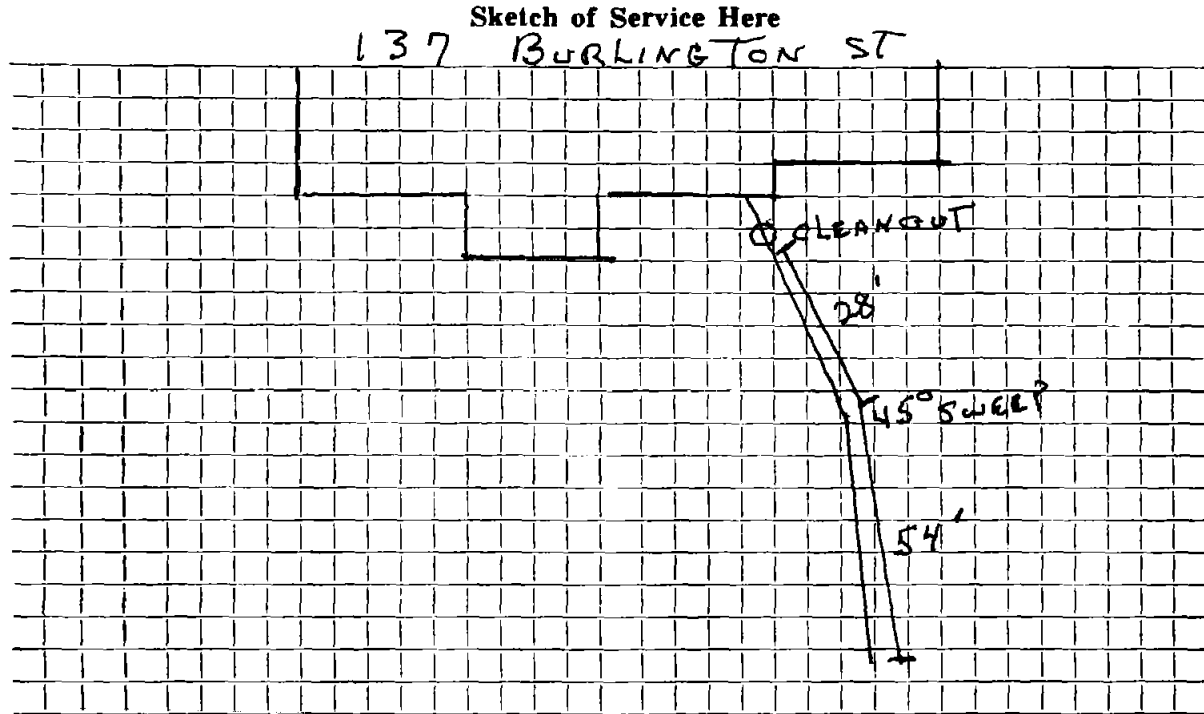

Connection made in BURLINGTON Street. Work completed 5-18-01

Remarks: INSTALLED BY D.H. FOWLE CO. INC.