

Name Elton Harris

Service No. 137

Address 145 Burlington Street

Lot #4

Location

FEB 12 1973

Kind of Pipe

Size

Size of Main

Repair—Renewal—New Service

Kel-Scot #2208

Location


Date		Material	Amount	Total	Date	Amount
Nov. '67	18'	6" Transite pipe @	6.50	117.00	9/21/72	117.00
						Deposit
10/10/72	41'	6" Transite			11- - 67	
	10'	4" Cast Iron			18'	6" Transite
6-13-94		Renewal				
	10'	6" PVC				
		1 6" X 6" Fernco				
		1 4"-45° Elbow				
		1 4"-22° Elbow				
		1 4" X 6" Wye C.O.				
		1 4" X 4" Fernco				

DATE _____

TOWN OF LEXINGTON — BOARD OF PUBLIC WORKS
SEWER DIVISION

Sketch of Service Here

145

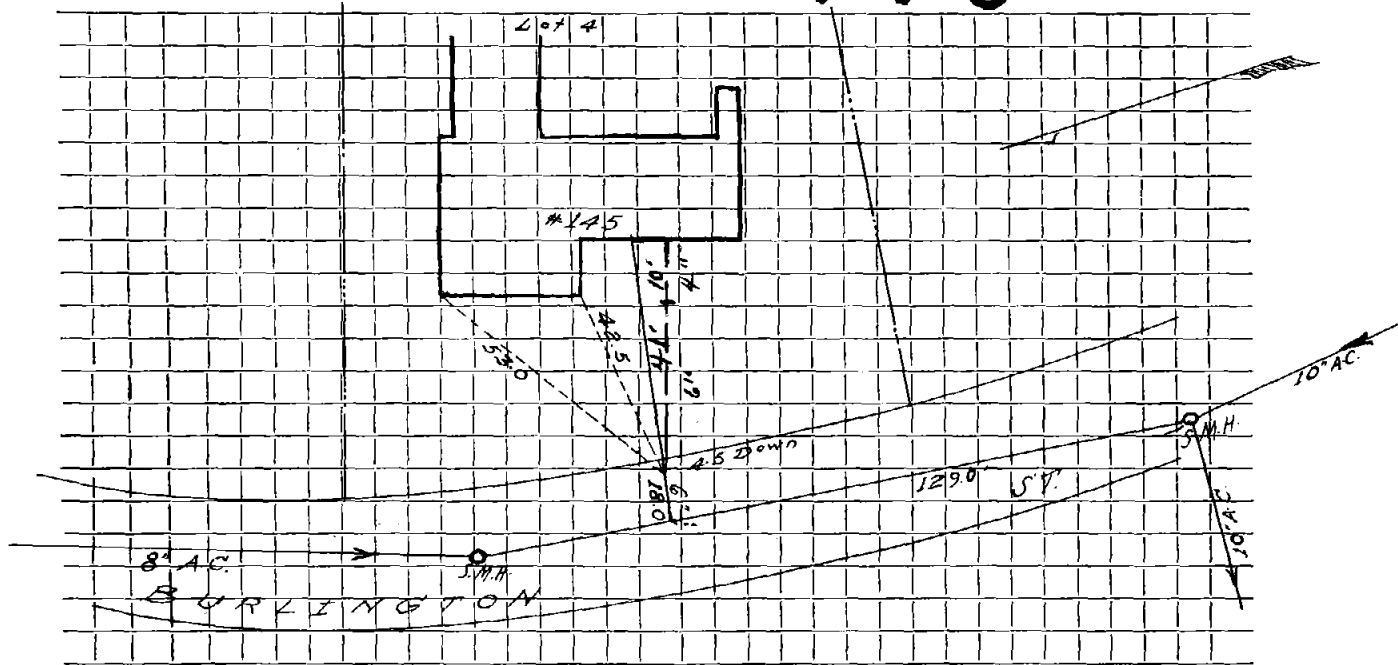

Connection made in Street. Work completed

Remarks:
.....
.....