


DATE 7/27/93

TOWN OF LEXINGTON — BOARD OF PUBLIC WORKS
SEWER DIVISION

Sketch of Service Here **146**

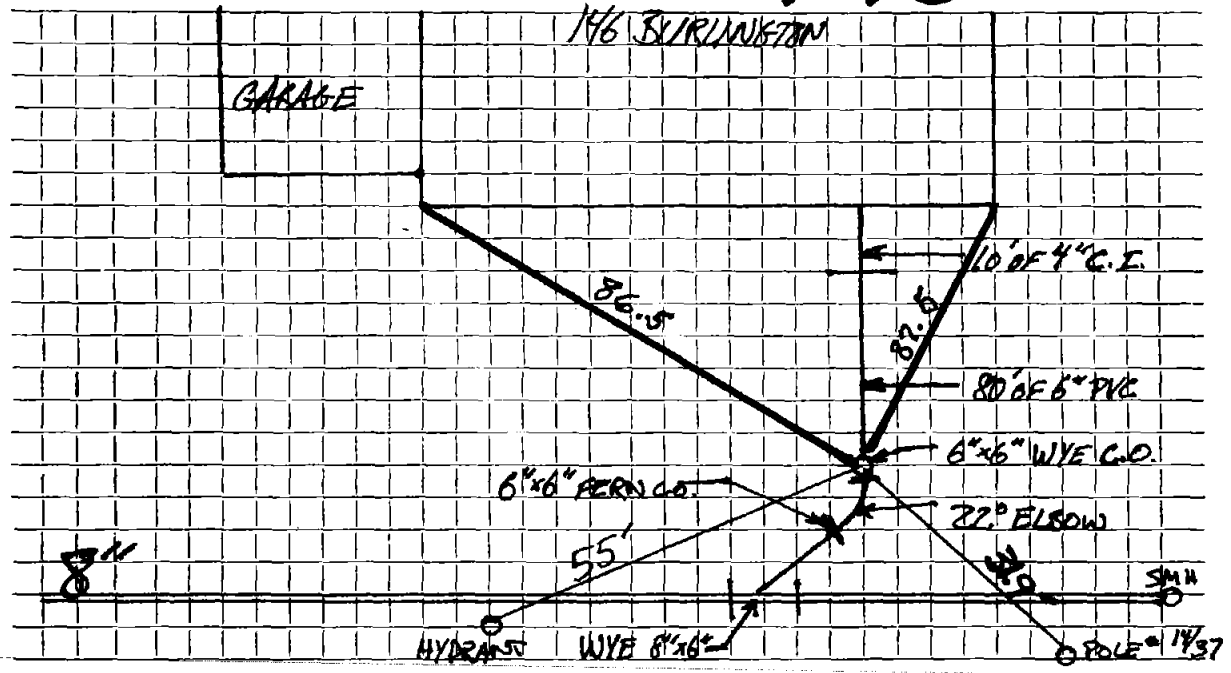

Connection made in Street. Work completed

Remarks:
.....
.....