

Name Melvin W. Zolot

Service No. 167

Address 147 Burlington Street

Lot #5

Location

Kind of Pipe

Size

Size of Main

Repair—Renewal—New Service

DeFlice #854

Location

MAY 13 1968


Date		Material	Amount	Total	Date	Amount
Nov. '67	22'	6" Transite pipe @ 6.50				
Nov. '67	22'	6" Transite pipe	6.50	143. 00	11-17-67	Deposit 143 00
12-4-67	43'	6" Transite pipe				
	10'	4" Cast Iron Pipe			11- - 67	
					22' 6" Transite	

DATE _____

TOWN OF LEXINGTON — BOARD OF PUBLIC WORKS

SEWER DIVISION

Sketch of Service Here **147**

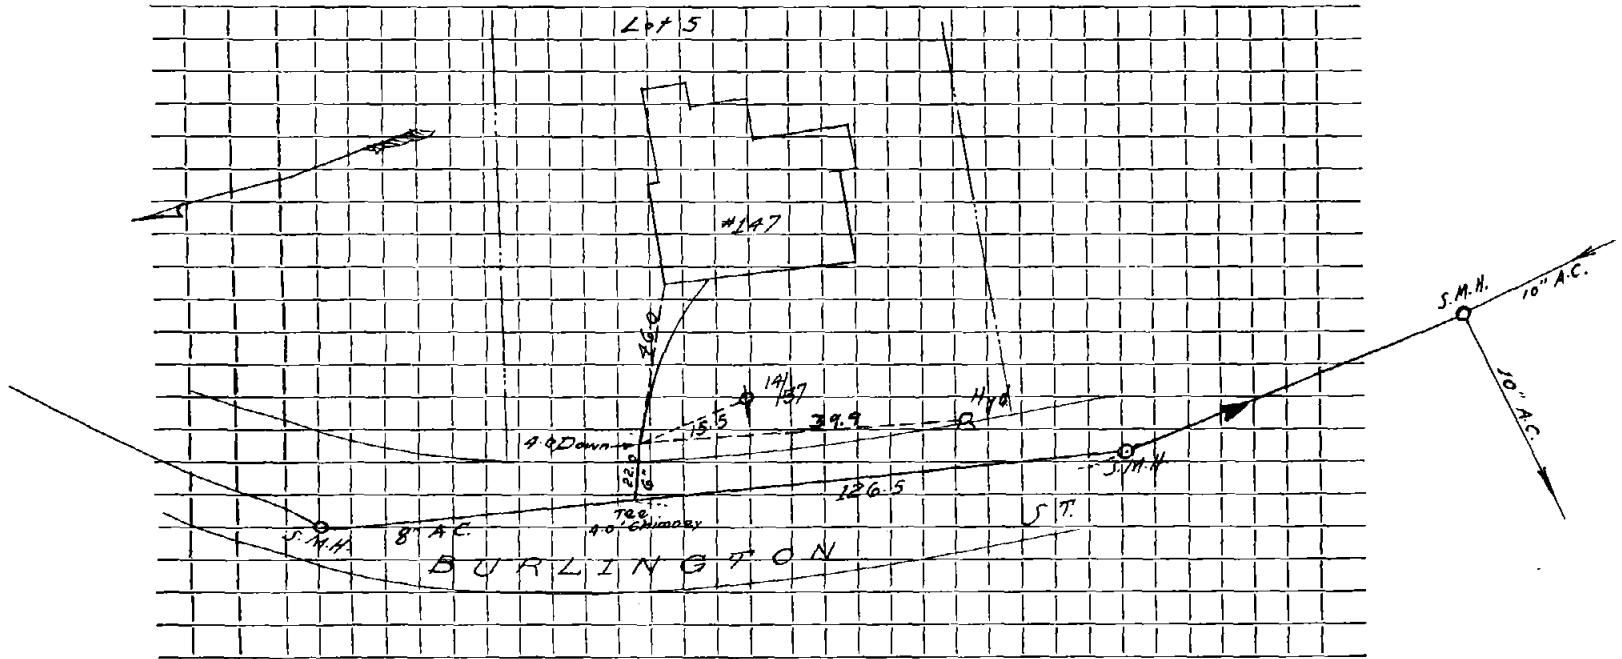

Connection made in Street. Work completed

Remarks:

.....

.....