

Name

Service No.

Address

149 Buelington St

Location

Kind of Pipe

Size

Size of Main

Repair Renewal New Service

Location

Date

Material

Amount

Total

Date

Amount

8-24-04

10'-4" PVC
 4x6 PVC to PVC Ferruco
 43' -6" PVC
 6x6 PVC to AC Ferruco


11-07

23' -6" TRANS

DATE _____

TOWN OF LEXINGTON — BOARD OF PUBLIC WORKS
SEWER DIVISION

Sketch of Service Here

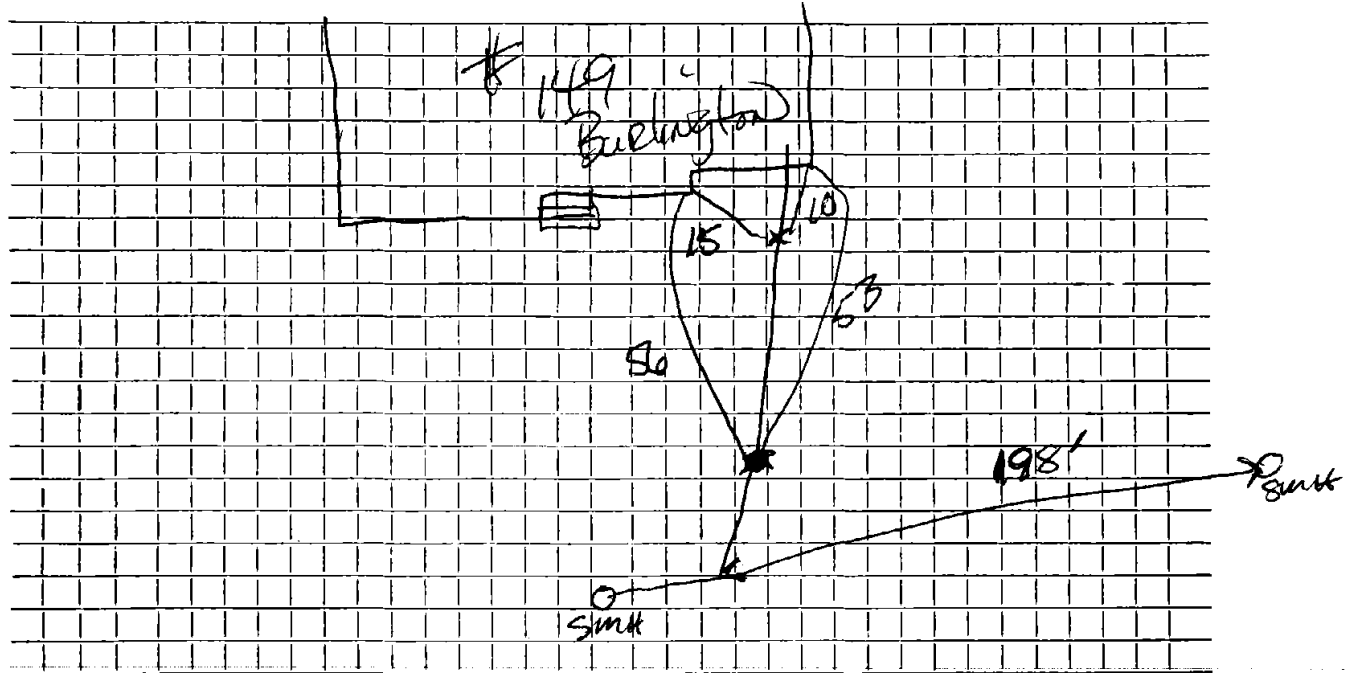

Connection made in Street. Work completed

Remarks: 6' chimney

.....
.....