


DATE 5/24/18

TOWN OF LEXINGTON — BOARD OF PUBLIC WORKS
SEWER DIVISION

Sketch of Service Here

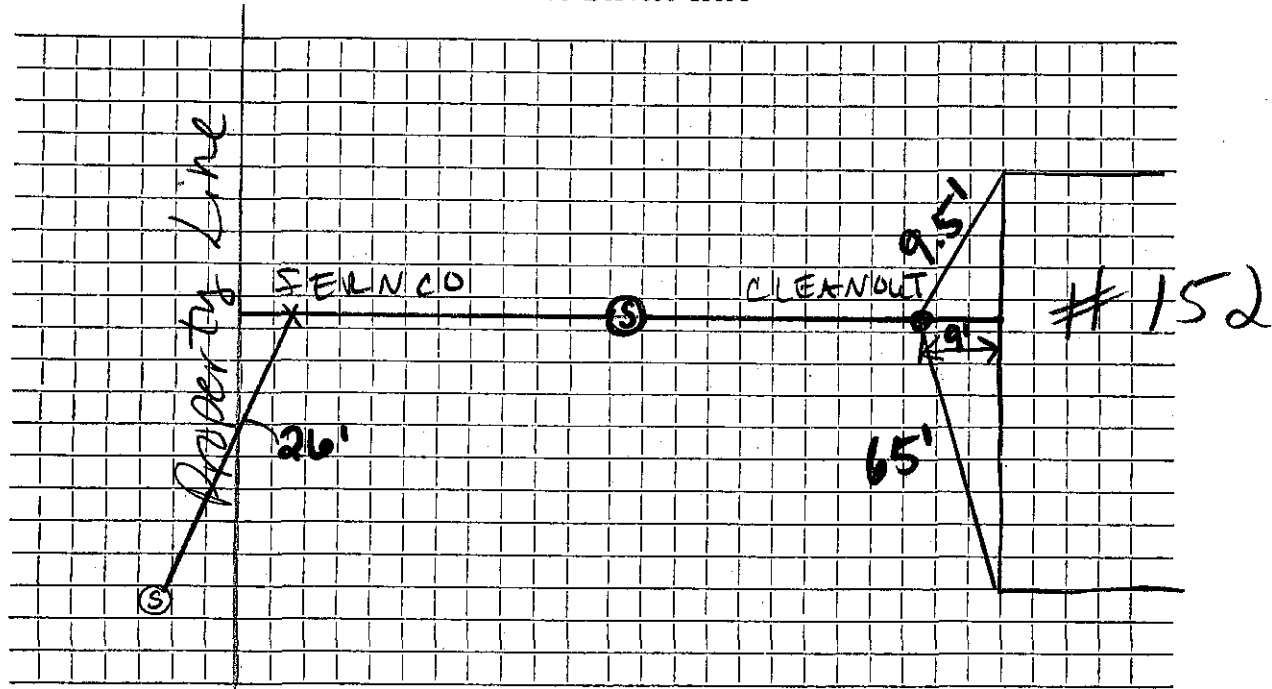

Connection made in ... Burlington Street. Work completed

Remarks:
6" ferro to existing 6" cast