




DATE Nov 1967

TOWN OF LEXINGTON — BOARD OF PUBLIC WORKS

SEWER DIVISION

Sketch of Service Here

**158**

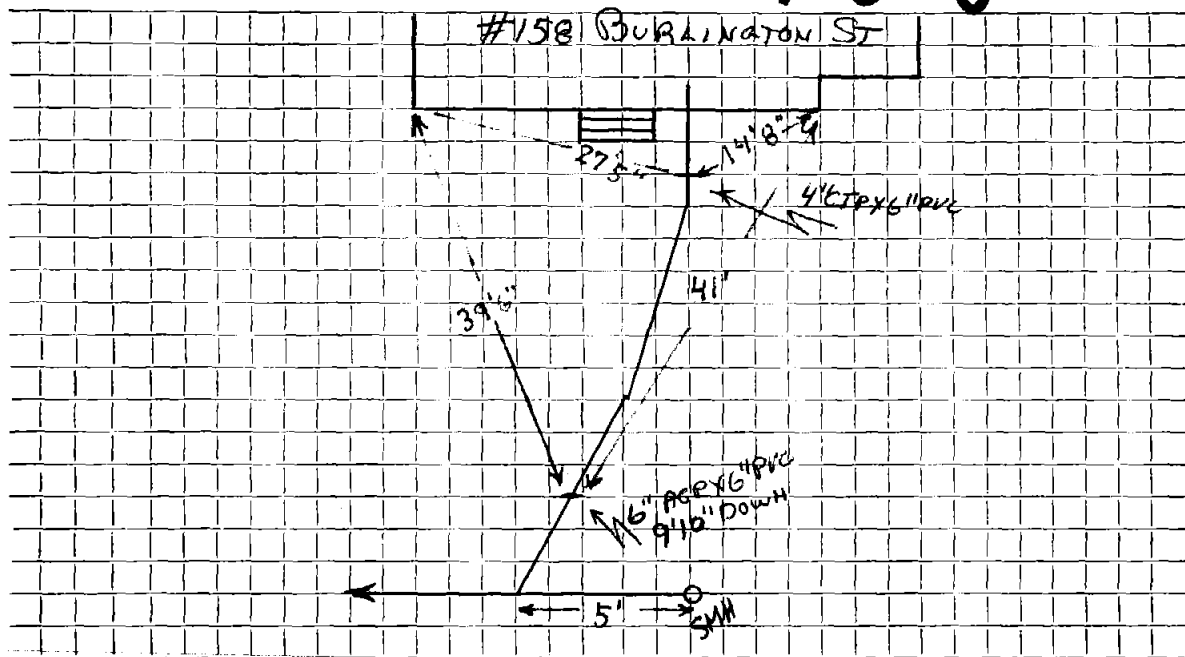

Connection made in BURLINGTON ST Street.

Work completed JAN 4, 1985

Remarks: .....

.....

.....