

Name Charles Hufton

Service No. 87

Address 162 Burlington Street

Pt. Lot #3

Location

Kind of Pipe

Size

Size of Main

Repair—Renewal—New Service Craftsman #1922

Location JUN 5 1972

Date		Material	Amount	Total	Date	Amount
------	--	----------	--------	-------	------	--------

Nov. 167	11'	6" Transite pipe	6.50	91.00	10-20-71	Deposit	91.00
11-8-71	115'	6" Transite pipe					
	52'	4" Cast Iron pipe			11- -67		
					14' 6" Transite		


DATE _____

TOWN OF LEXINGTON — BOARD OF PUBLIC WORKS

SEWER DIVISION

Sketch of Service Here

162

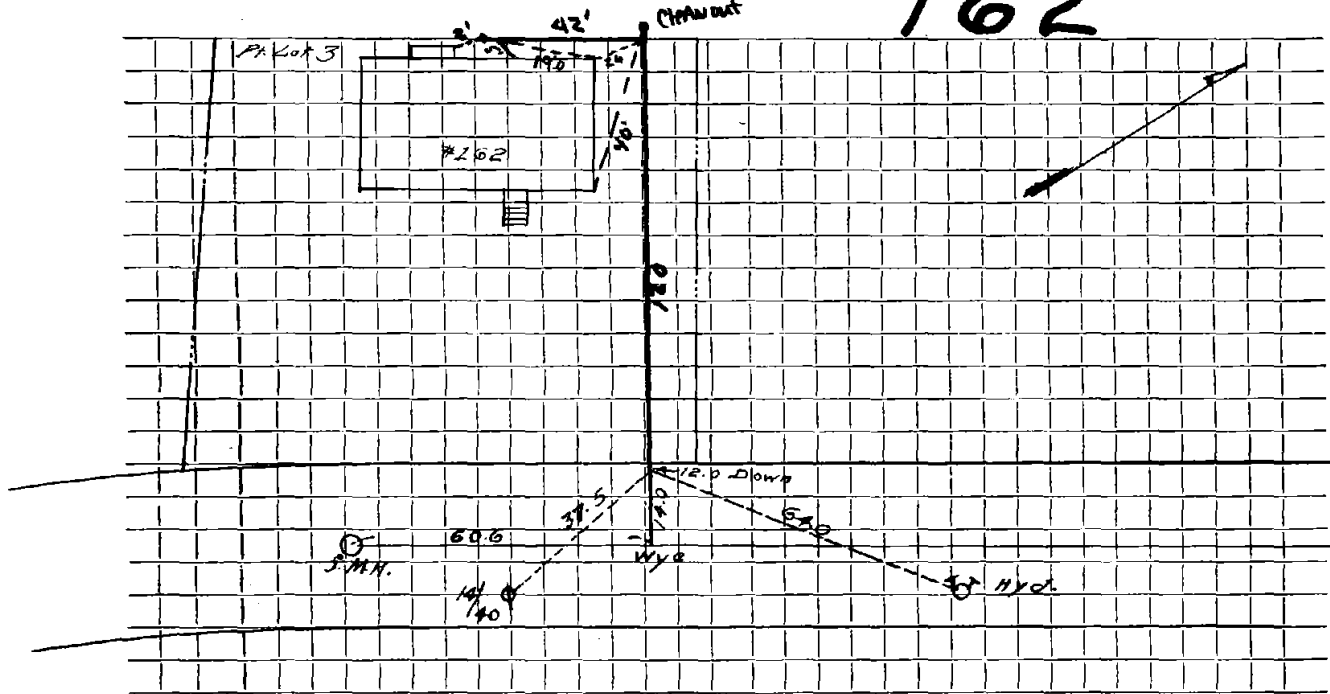

Connection made in Street. Work completed

Remarks:
.....
.....