

Name David B. Dole

Service No. 87

Address 163 Burlington Street

Lot #9

Location Lot 9

Kind of Pipe

Size

Size of Main

~~Repair Renewal~~ New Service Dave Eagle permit #2095

Location AUG 14 1972


Date	Material	Amount	Total	Date	Amount
Nov. '67	21' 6" Transite pipe @	6.50	136.50	6-14-72	136.50
				Deposit	
				11- -67	
7/5/72	42' 6" Transite			21' 6" Transite	
	10' 4" Cast Iron				

DATE _____

TOWN OF LEXINGTON — BOARD OF PUBLIC WORKS

SEWER DIVISION

Sketch of Service Here **163**

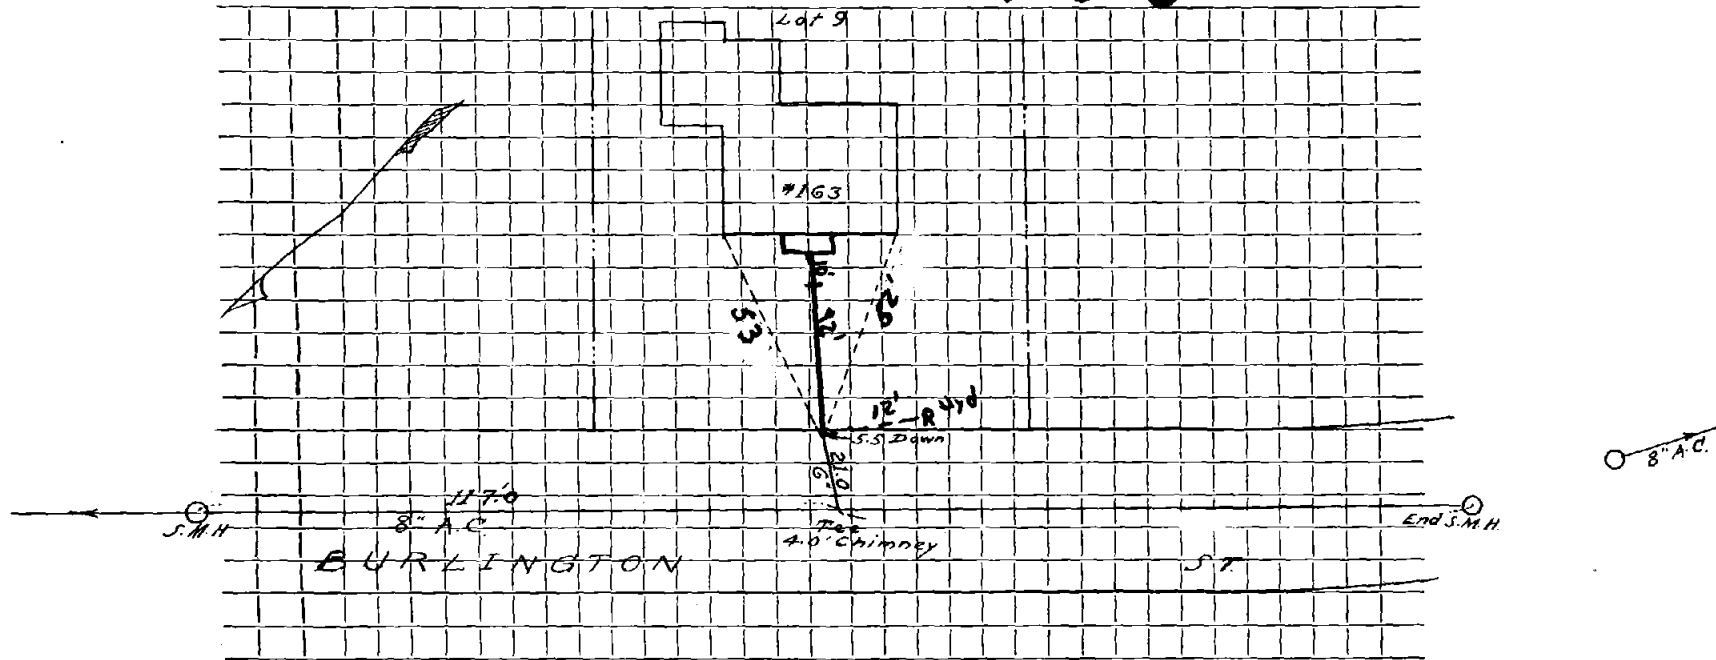

Connection made in Street. Work completed

Remarks:
.....
.....