

Name Paul Hoirris

Service No. 94

Address 166 Burlington Street

Pt. Lot #4

Location

Kind of Pipe

Size

Size of Main

Repair—Renewal—New Service


Location JAN 27 1969

Date	Material	Amount	Total	Date	Amount	
Nov. '67 11'	6" Transite pipe @	6.50	71.50	10-2-68	Deposit	71.50
10-9-68	61'	6" Transite pipe		11- -67		
	10'	4" Cast Iron pipe		11' 6" Transite		

DATE _____

TOWN OF LEXINGTON — BOARD OF PUBLIC WORKS
SEWER DIVISION

Sketch of Service Here **166**

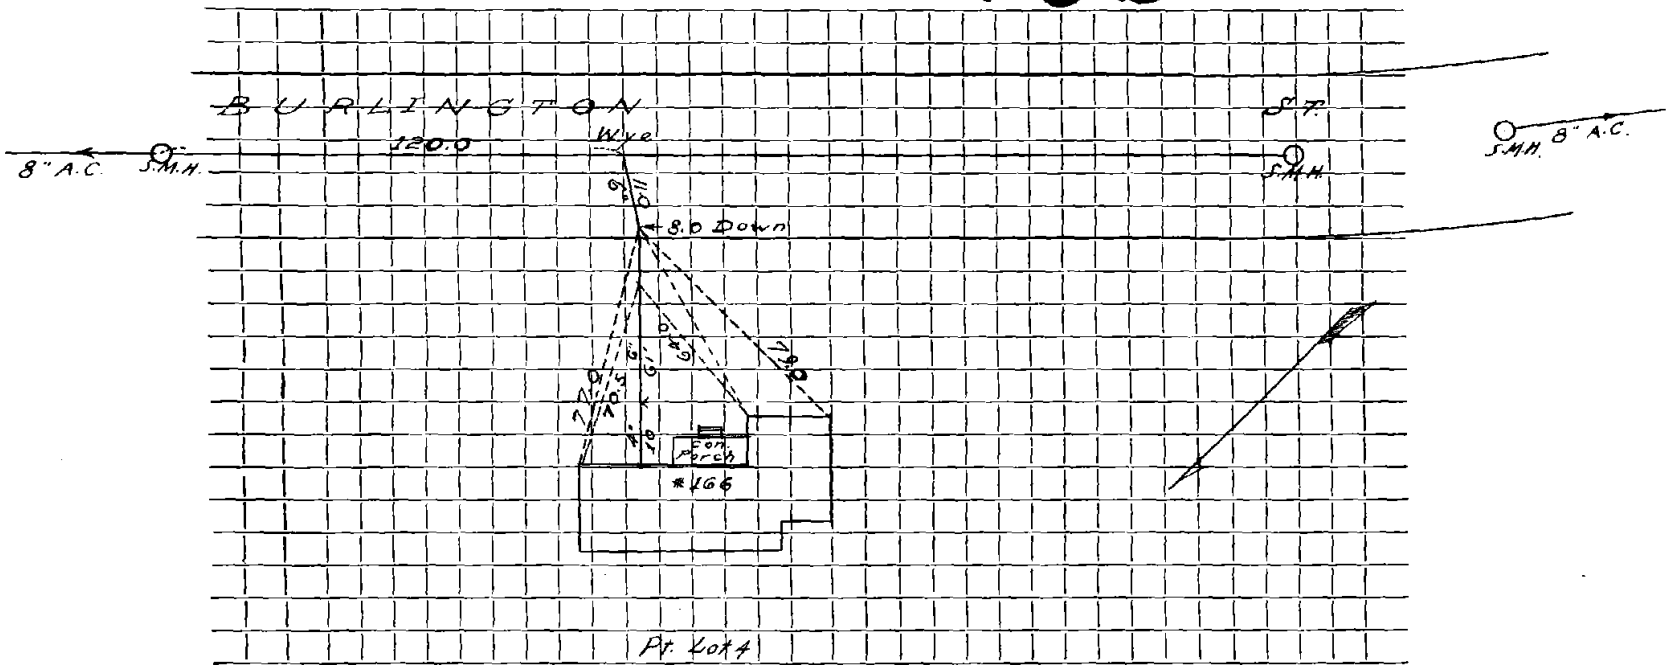

Connection made in Street. Work completed

Remarks:
.....
.....