

Name James Murphy

Service No. 168

Address 168 Burlington Street

Pt. Lot #5

Location

Kind of Pipe

Size

Size of Main

Repair—Renewal—New Service Suburbanite Cesspool #855

Location MAY 13 1968

Date		Material	Amount		Total		Date	Amount
<del>Nov. '67 16'</del>		<del>6" Transitopipe @</del>	6.50		104.00		11-30-67	Deposit
11-21-67		6" Transite pipe					11- -67	
							16' 6" Transite	
							8/10/68	Main safety cone in manhole


DATE \_\_\_\_\_

TOWN OF LEXINGTON — BOARD OF PUBLIC WORKS

SEWER DIVISION

GRAHAM RD.

Sketch of Service Here **168**

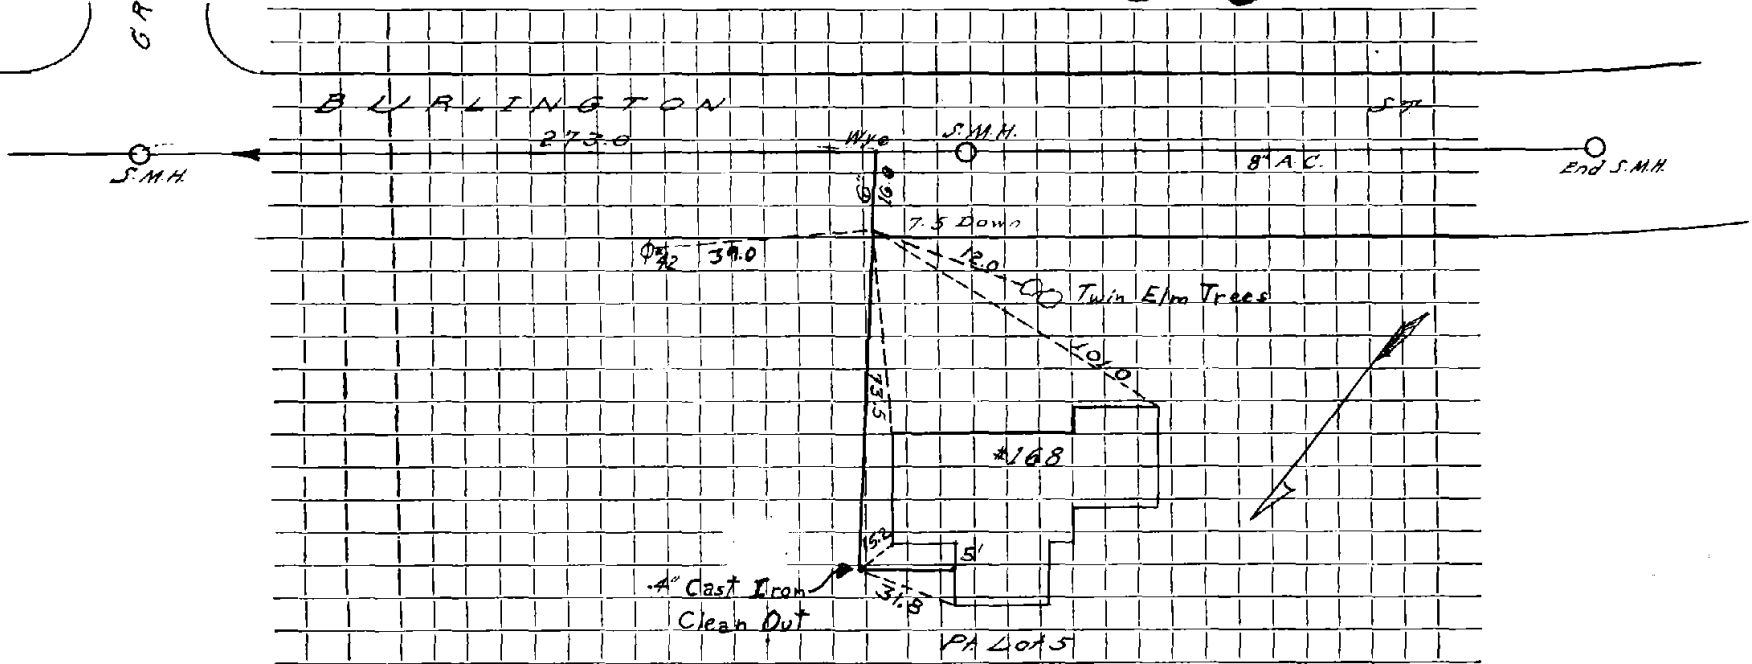

Connection made in ..... Street, Work completed .....

Remarks: .....

.....  
.....