

Name Angelo Moreno

Service No. 165

Address 171 Burlington Street

Lot #11

Location

Kind of Pipe

Size

Size of Main

Repair—Renewal—New Service Suburbanite #851

Location 18750


Date		Material	Amount	Total	Date		Amount
1967	18'	6" Transite pipe @6.50		117.00	11-15-68	Deposit	117.00
11-20-67	70'	6" Transite pipe					
	10'	4" Cast Iron Pipe			11 - 67		
						18' 6" Transite	

R.B.M. 18501

DATE _____

TOWN OF LEXINGTON — BOARD OF PUBLIC WORKS
SEWER DIVISION

Sketch of Service Here **171**

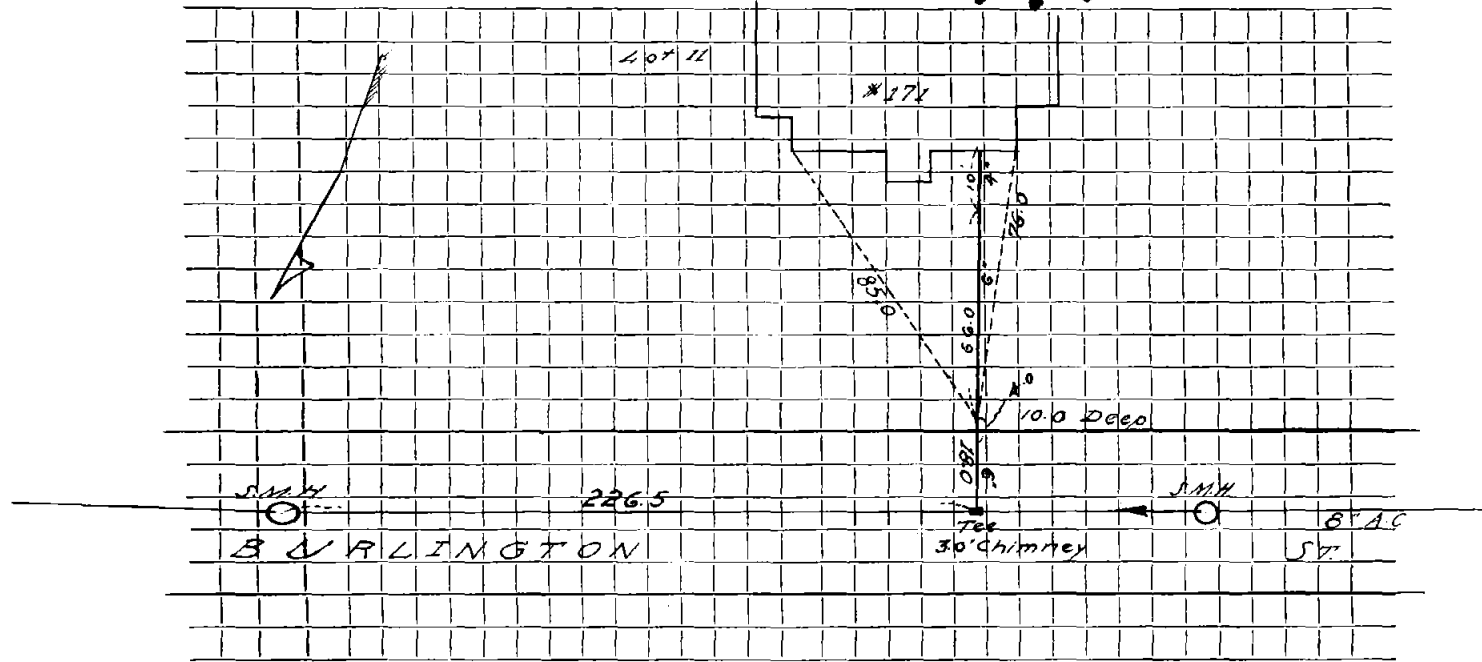

Connection made in Street. Work completed

Remarks:
.....
.....