



DATE 11-19-90


TOWN OF LEXINGTON — BOARD OF PUBLIC WORKS

SEWER DIVISION

#172 BURLINGTON ST.

Sketch of Service Here

172

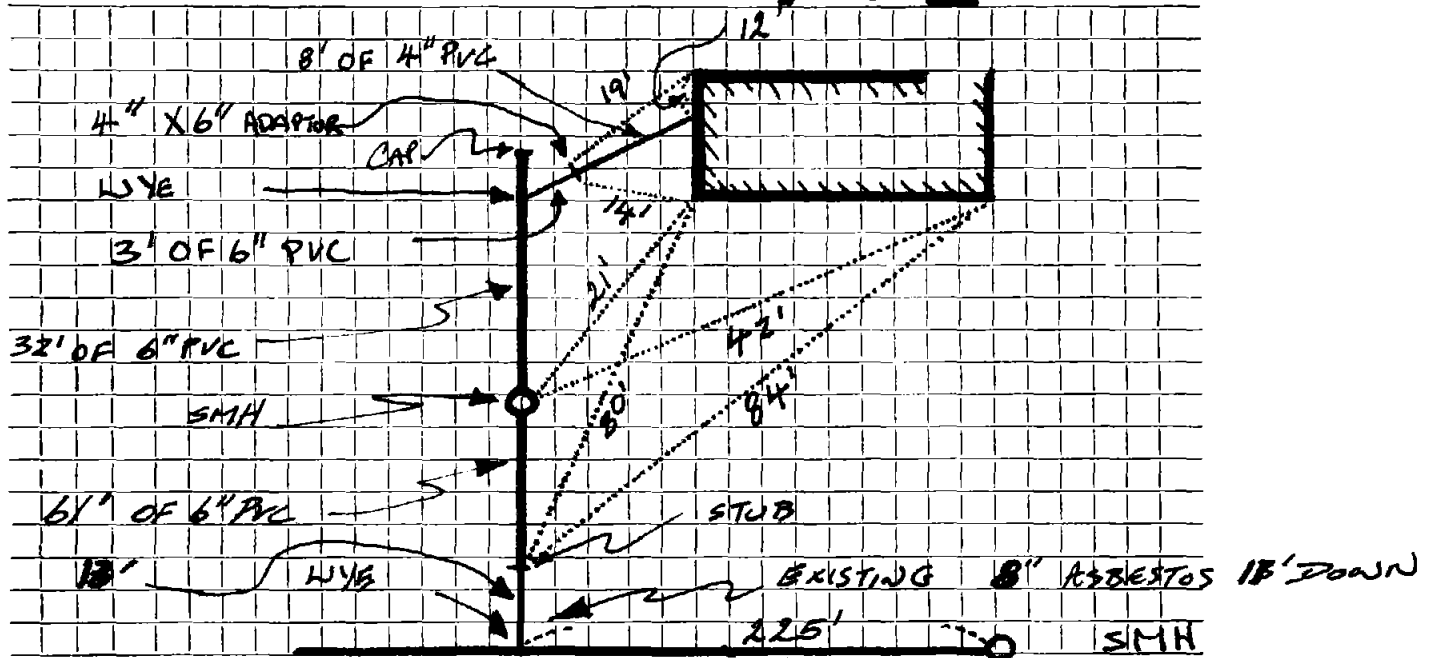

Connection made in BURLINGTON Street. Work completed

Remarks: INSP: S.M. CONTR: BANKS

GERMAN Ad.