

Name *Clark W. Bryan*

Service No. *92*

Address *176 Burlington Street*

Pt. Lot *#7*

Location

Kind of Pipe

Size

Size of Main

Repair—Renewal—New Service

Valeri Construction #3047

Location

FEB 13 1978

Date

Material

Amount

Total

Date

Amount

~~Nov. '67 15' 6" Transitepipe @ 6.50~~

97. 00

~~10/14/77~~

Deposit

97.00

10/31/77 160' - 6" AC ; 5' - 4" CI


11- - 67

15' 6" Transite

DATE _____

TOWN OF LEXINGTON — BOARD OF PUBLIC WORKS

SEWER DIVISION

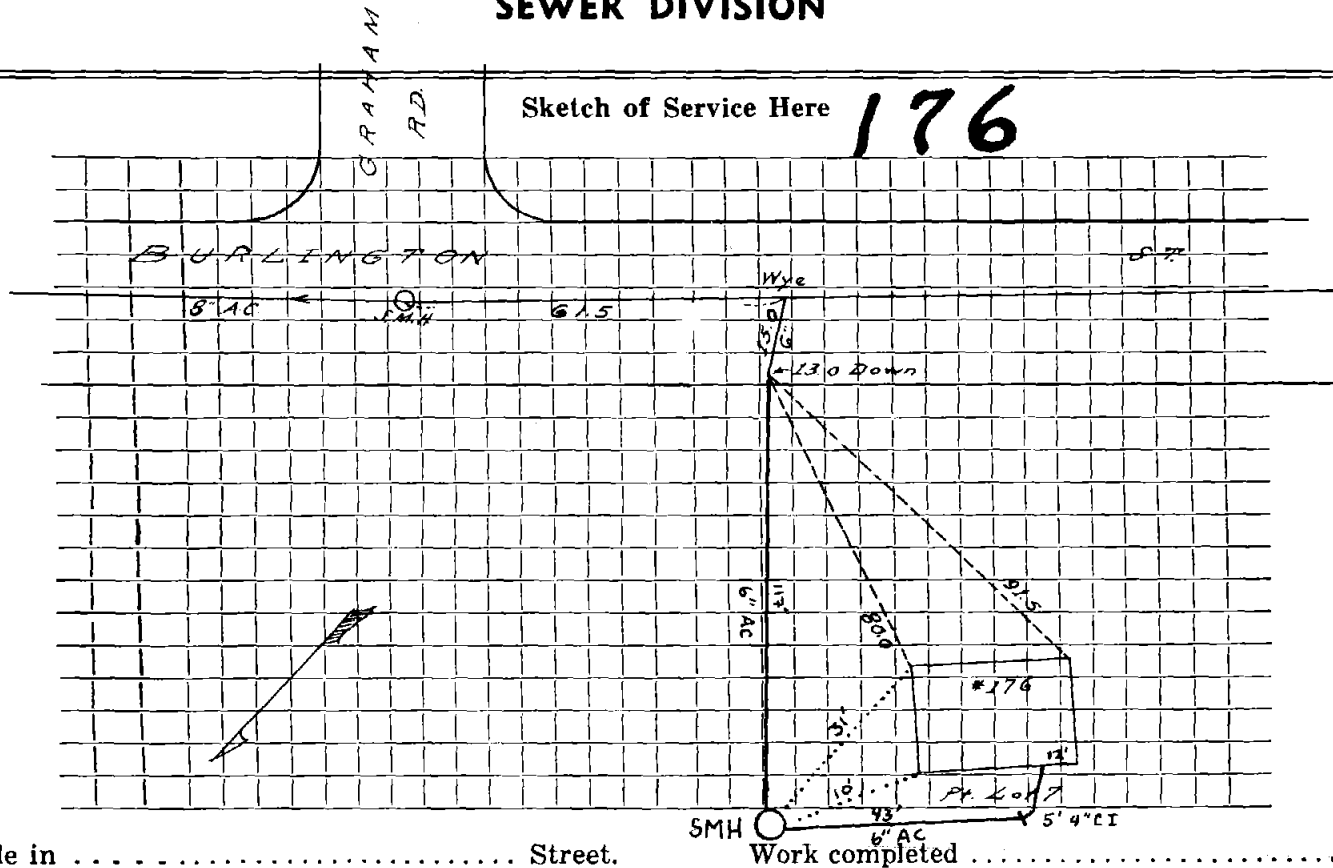

Remarks:

.....

.....