

Name Bernard Belcastro

Service No. 160

Address 177 Burlington Street

Lot #10

Location

Kind of Pipe

Size

Size of Main

Repair—Renewal—New Service Suburbanite #841


Location MAR 18 1968

Date	Material	Amount	Total	Date	Amount
<del>1967</del> 17-	<del>6" Transite pipe @</del>	<del>6.50</del>	110.50		
11-14-67	30' 6" Transite pipe				
	8' 4" Cast Iron pipe			11- - 67	
				17' 6" Transite	

DATE \_\_\_\_\_

TOWN OF LEXINGTON — BOARD OF PUBLIC WORKS  
SEWER DIVISION

Sketch of Service Here **177**

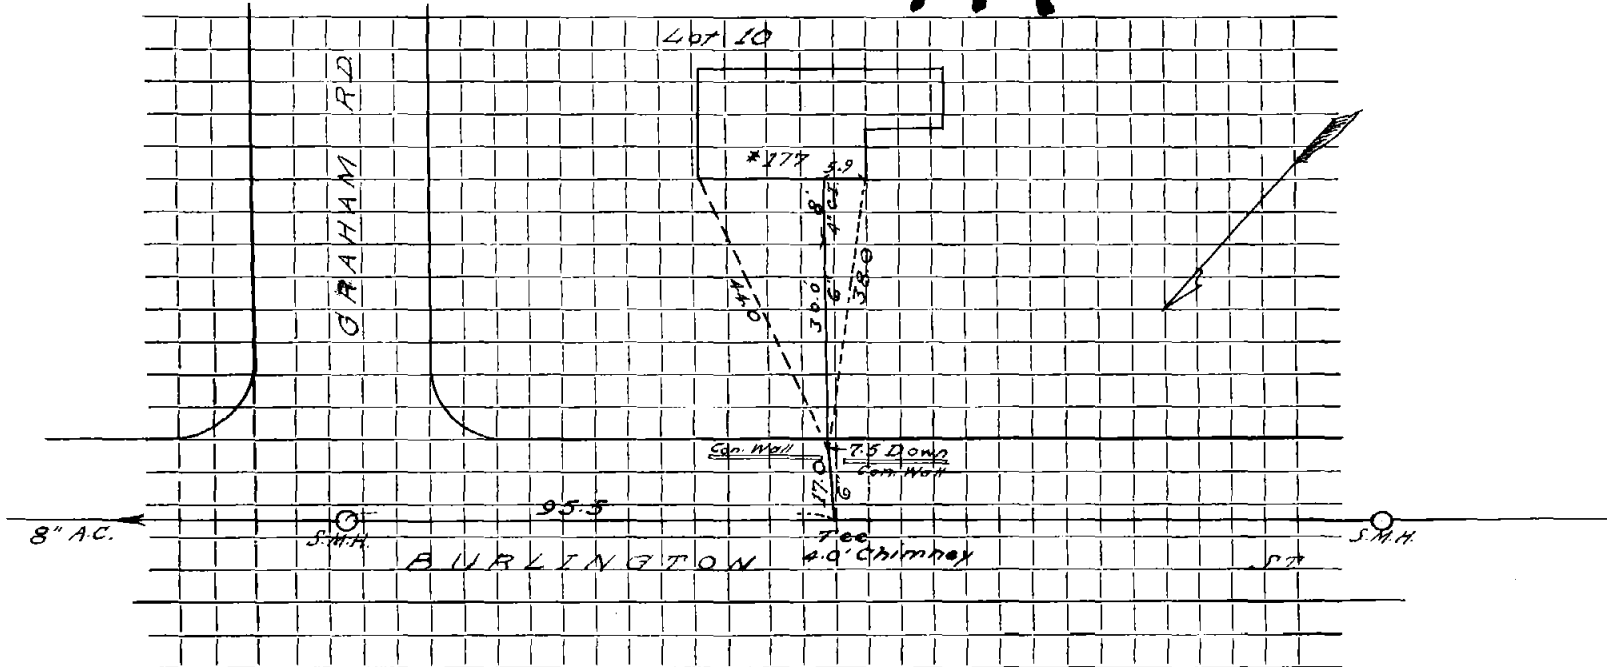

Connection made in ..... Street. Work completed .....

Remarks: .....  
.....  
.....