

Name Frank Nestico

Service No. 23

Address 184 Burlington Street

Pt. Lot #9

Location

Kind of Pipe

Size

Size of Main

~~Repair/Extend~~ New Service Redmond #3704

Location

SEP 21 1981

| Date | | Material | Amount | Total | Date | | Amount |
|--------------------|---------------|---|-----------------|--------------------|--------------------|----------------|-------------------|
| Nov. 16 | 16 | 6" Transite pipe @ | 6.50 | 104. 00 | 5-18-81 | <i>Deposit</i> | 104.00 |
| 5/22/81 | 37' | x 6" P.V.C. | | | | | |
| | 10' | x 4" C.I.P. | | | 11- - 67 | | |
| | 1 | 22 ¹ / ₂ x 6' P.V.C Elbow | | | 16' 6" Transite | | |
| | | | | | | | |
| | | | | | | | |

DATE _____

TOWN OF LEXINGTON — BOARD OF PUBLIC WORKS
SEWER DIVISION

Sketch of Service Here

184

GRAMHAM RD

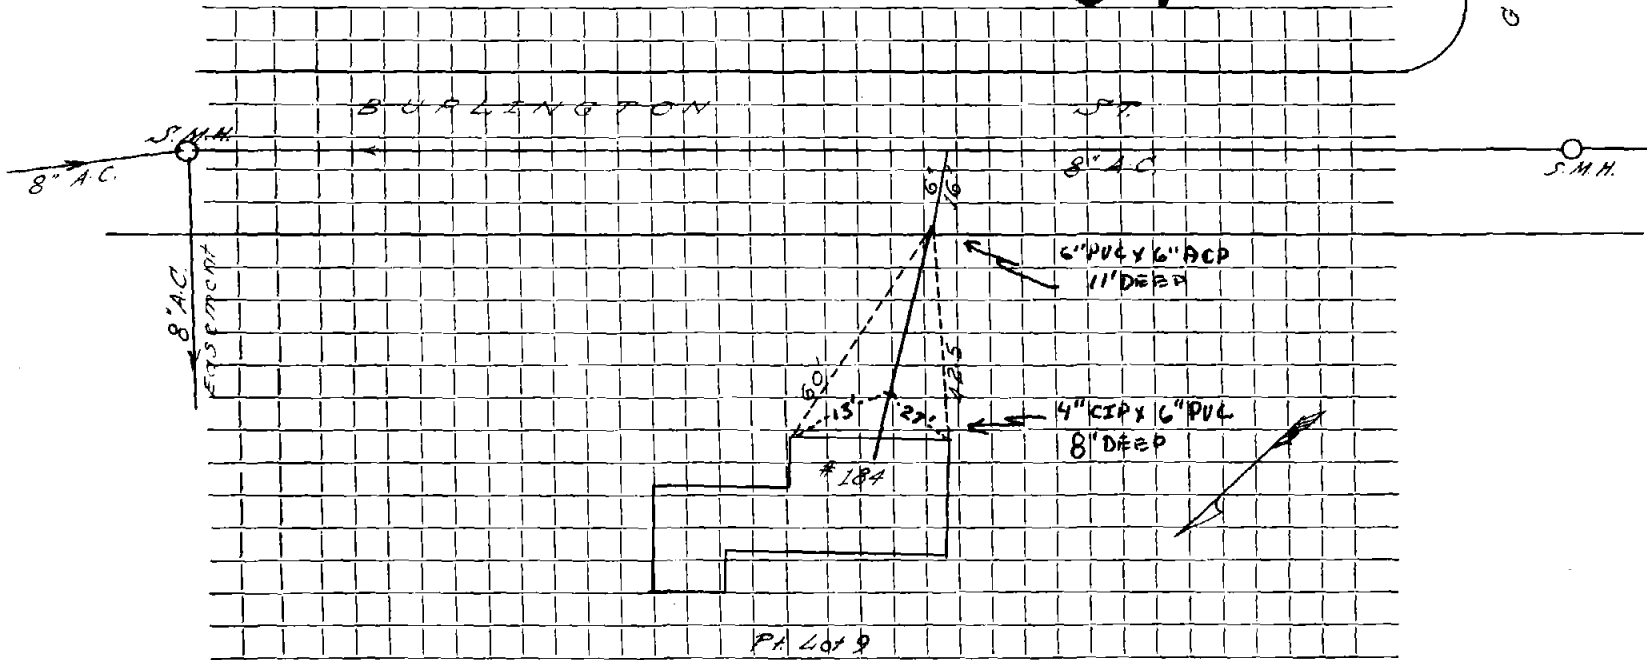

Connection made in Street. Work completed

Remarks:
.....
.....