

Name Richard A. Tilden Jr.

Service No. 78

Address 185 Burlington Street

Lot A

Location

Kind of Pipe

Size

Size of Main

Repair—Renewal—New Service Brucchi #1917

Location JUN 5 1972


Date		Material	Amount		Total	Date		Amount	
<del>Nov. 167</del>	<del>171</del>	<del>6" Transite pipe @</del>	<del>6.50</del>		<del>110.50</del>	<del>9-30-71</del>		<i>Deposit</i>	<del>110.50</del>
10-22-71	25'	6" Transite pipe							
	10'	4" Cast Iron pipe				11-	- 67		
							17'	6" Transite	

DATE \_\_\_\_\_

# TOWN OF LEXINGTON — BOARD OF PUBLIC WORKS

## SEWER DIVISION

Sketch of Service Here **185**

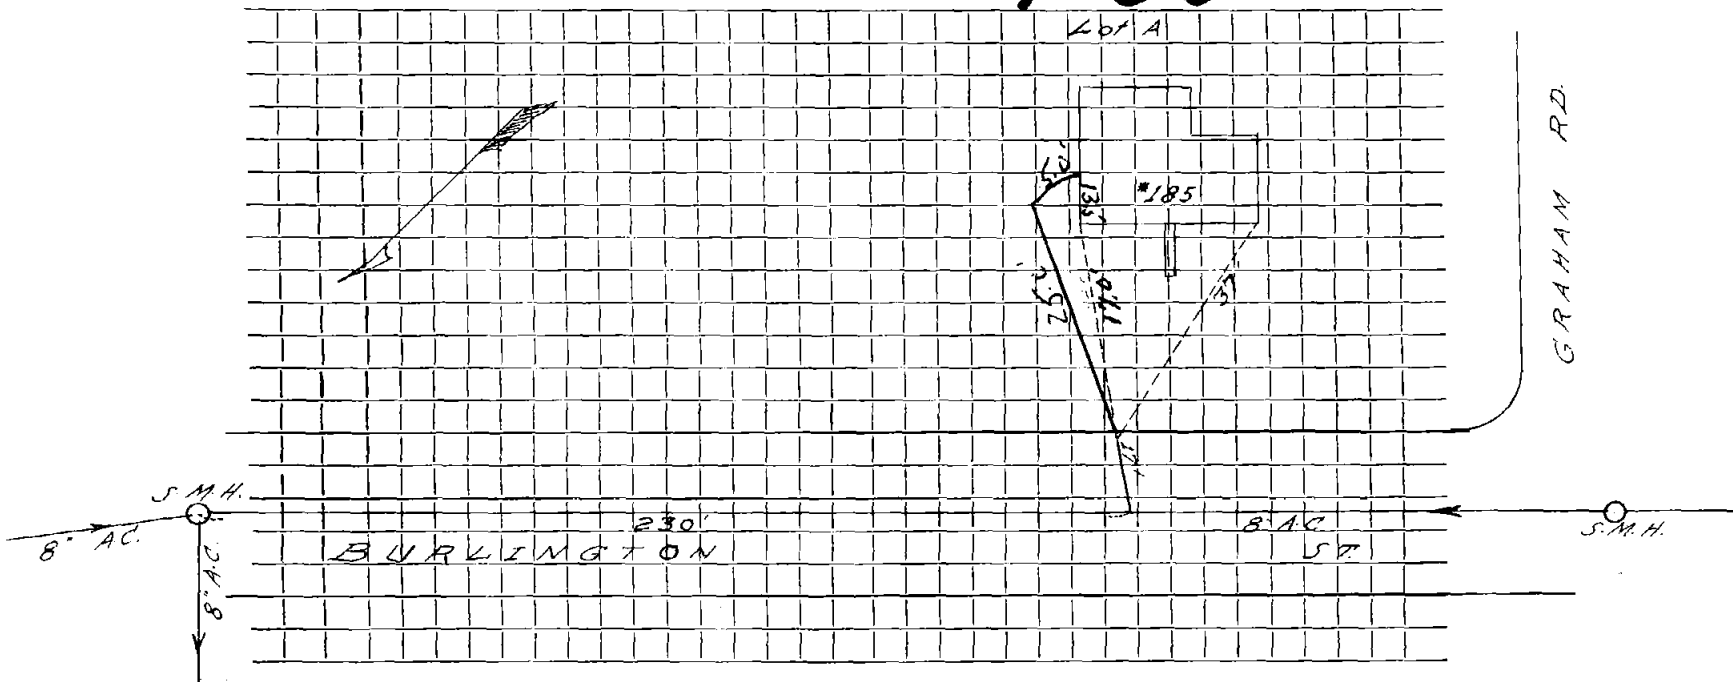

Connection made in ..... Street.      Work completed .....

Remarks: ..... **8.5 DEEP** .....  
.....  
.....