

Name MARSHA BERG

Service No.

Address #188 BURLINGTON STREET

Location

Kind of Pipe

Size

Size of Main

Repair—Renewal—

New Service

PERMIT NO. 0883 - KIRKLAND & SHAW

Location SEPTIC ABANDONMENT

Date

Material

Amount

Total


Date

Amount

10/17/96 48' - 6" ϕ PVC

DATE 17 OCTOBER 1996

TOWN OF LEXINGTON — BOARD OF PUBLIC WORKS
SEWER DIVISION

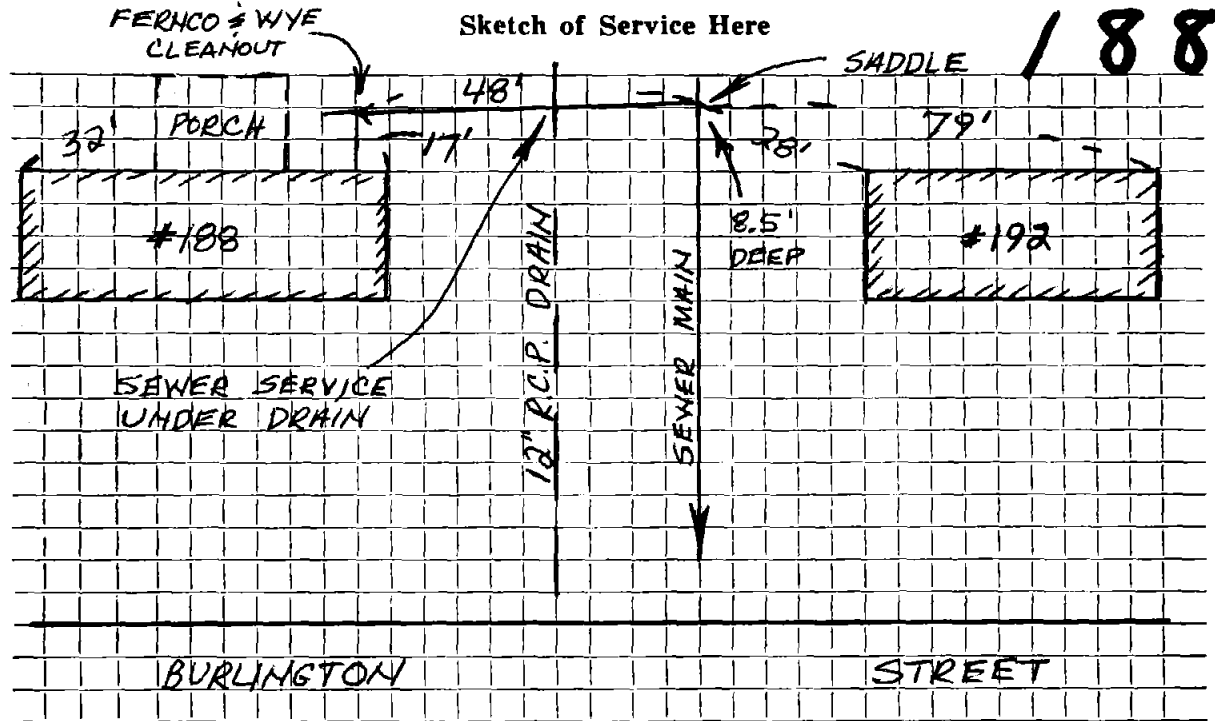

Connection made in BURLINGTON STREET Street.

Work completed KIRKLAND & SHAW

Remarks:

BOOK 96-5

JW