


DATE _____

TOWN OF LEXINGTON — BOARD OF PUBLIC WORKS
SEWER DIVISION

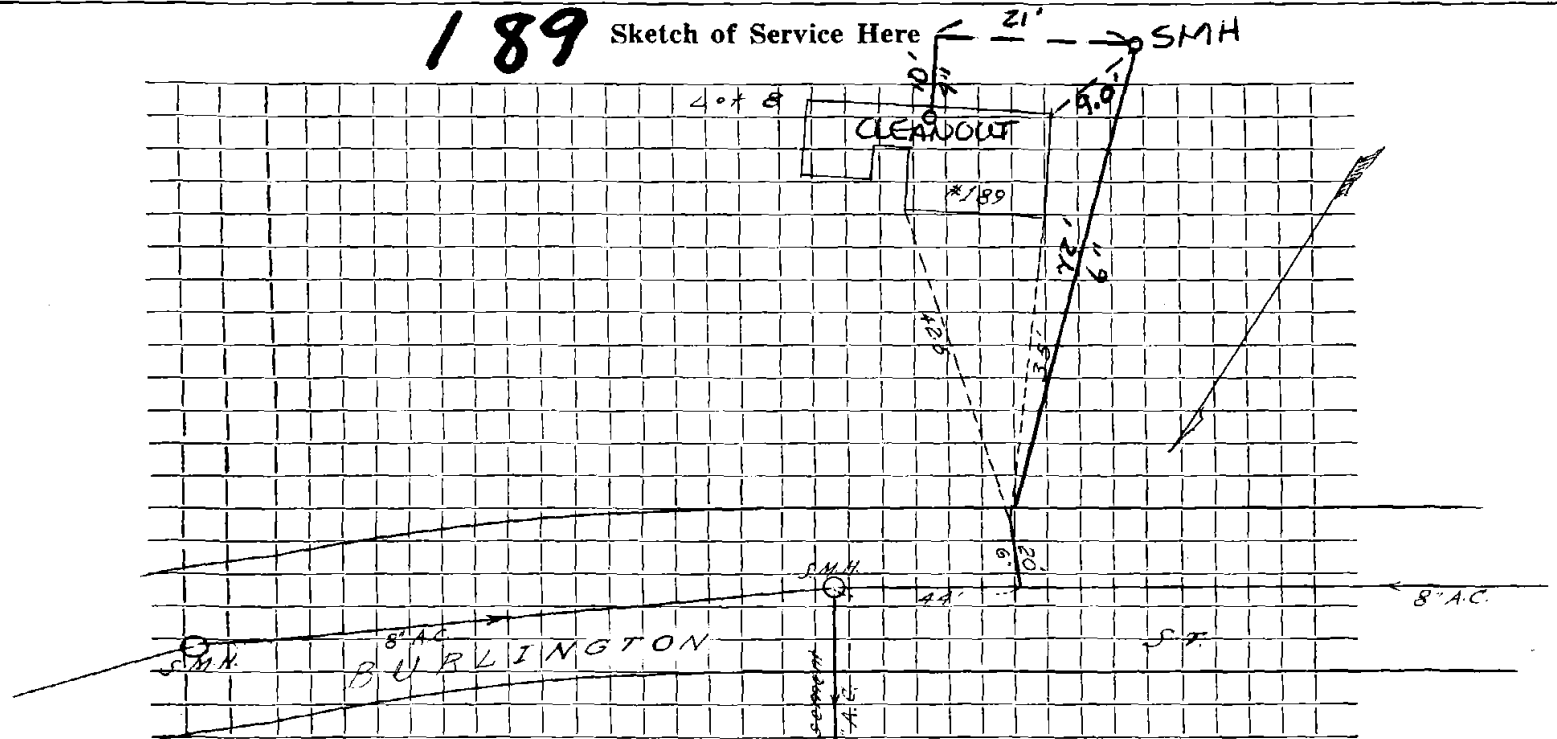

Connection made in ... **BURLINGTON** ... Street.

Work completed ... **4-2-75**

Remarks:

.....

.....