

Name

Service No.

Address

196 Buelington

Location

Kind of Pipe

Size

Size of Main

Repair—Renewal—New Service

Location

Date

Material

Amount

Total

Date

Amount

8.10.01

Inside installed

11.67

Outside

21.6' - 6" AC

4x6 PVC to PVC ferrico


6x6 AC to PVC ferrico

35.5' - 6" PVC

DATE _____

TOWN OF LEXINGTON — BOARD OF PUBLIC WORKS
SEWER DIVISION

Sketch of Service Here

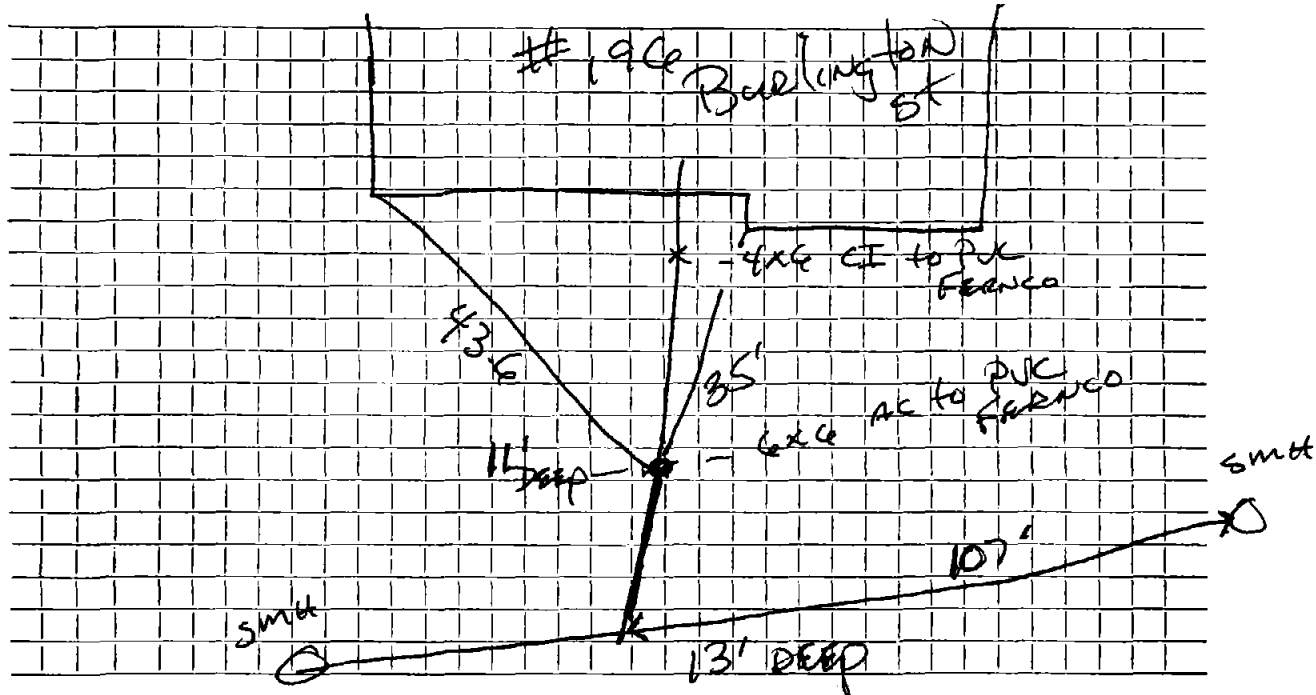

Connection made in Street. Work completed

Remarks:
.....
Service stub seem to be flat or
pitched backwards