

Name

Service No.

Address

198 Burlington St

Location

Kind of Pipe

Size

Size of Main

Repair—Renewal—New Service

Location

Date

Material

Amount

Total

Date

Amount


7.8.02

4x6 Fernco  
1-6" 22° Bend  
70'-6" PVC



DATE \_\_\_\_\_

**TOWN OF LEXINGTON — BOARD OF PUBLIC WORKS**  
**SEWER DIVISION**

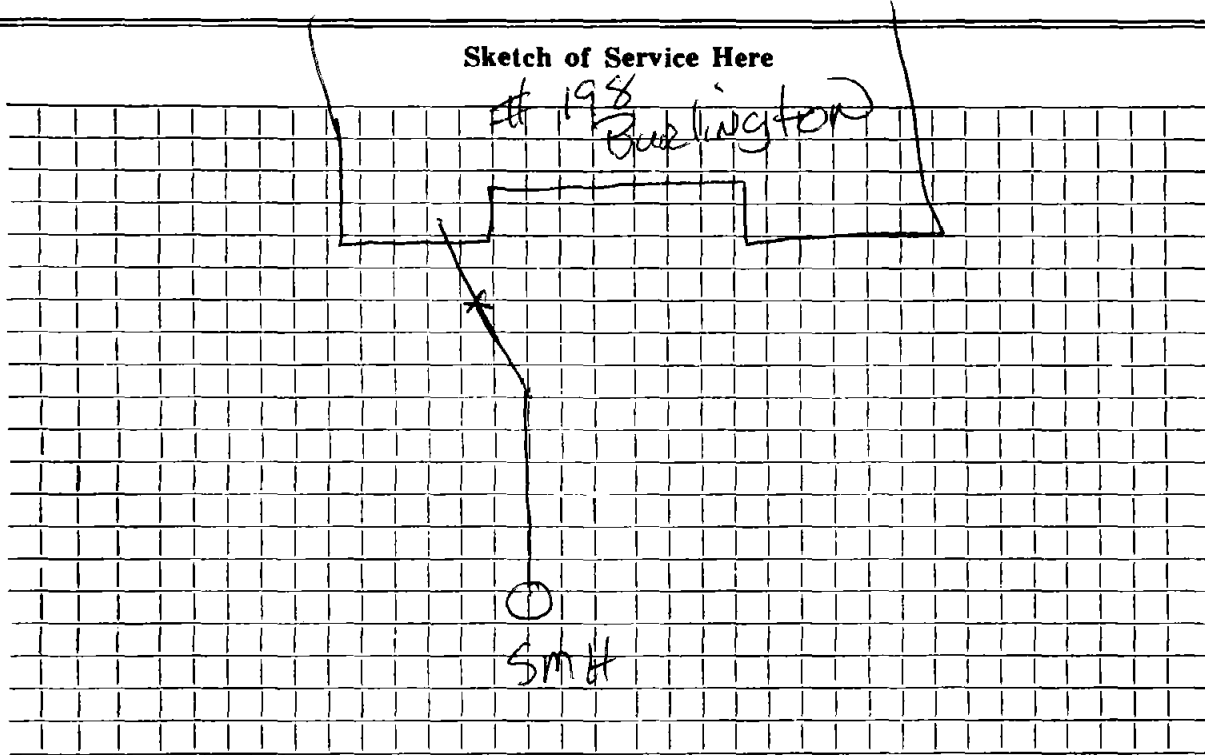

Connection made in ..... Street. Work completed .....

Remarks: .....  
.....  
.....  
.....

Service goes into the M.H.