

Name James Hardin

Service No. 3

Address # 22 BURLINGTON ST.

Location

Kind of Pipe

Size

Size of Main

~~REPAIR/RENEWAL~~ - New Service

Lexington Sewerage #940

Location

MAY 13 1968


Date		Material	Amount	Total	Date	Amount
8-27-62		Labor	36.50		2-14-68	66.30
		10% O.H.	3.65	40.15		
	10'	6" Transite pipe @.78		7.80		
	1	6" Transite Elbow		2.35		
	2	hrs. Town Shovel @6.50		13.00		
	1	hr. Trucking @3.00		3.00		
		BILL WHEN CONNECTED		66.30		
3-28-68	41'	6" Transite pipe				
	10'	4" Cast Iron Pipe				
					7-19-68	Debris

DATE \_\_\_\_\_

TOWN OF LEXINGTON — BOARD OF PUBLIC WORKS  
SEWER DIVISION

Sketch of Service Here

22

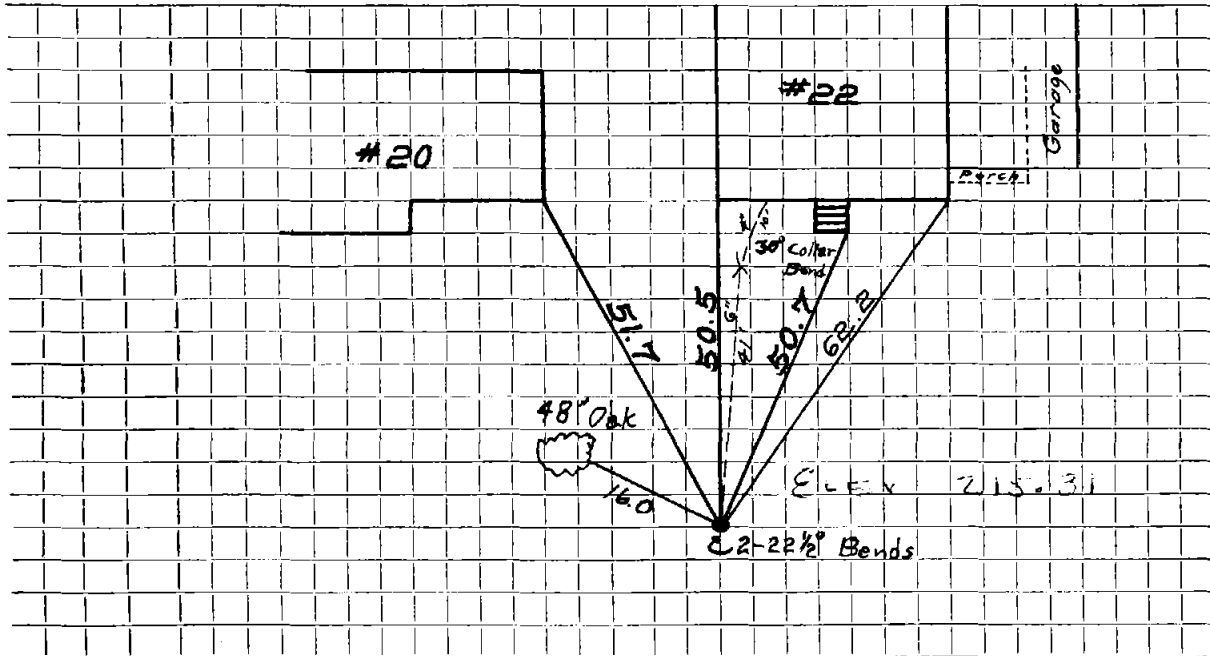

Connection made in ..... Street. Work completed .....

Remarks: .....

.....  
.....