


DATE 6-7-88

TOWN OF LEXINGTON — BOARD OF PUBLIC WORKS
SEWER DIVISION

Sketch of Service Here **28**

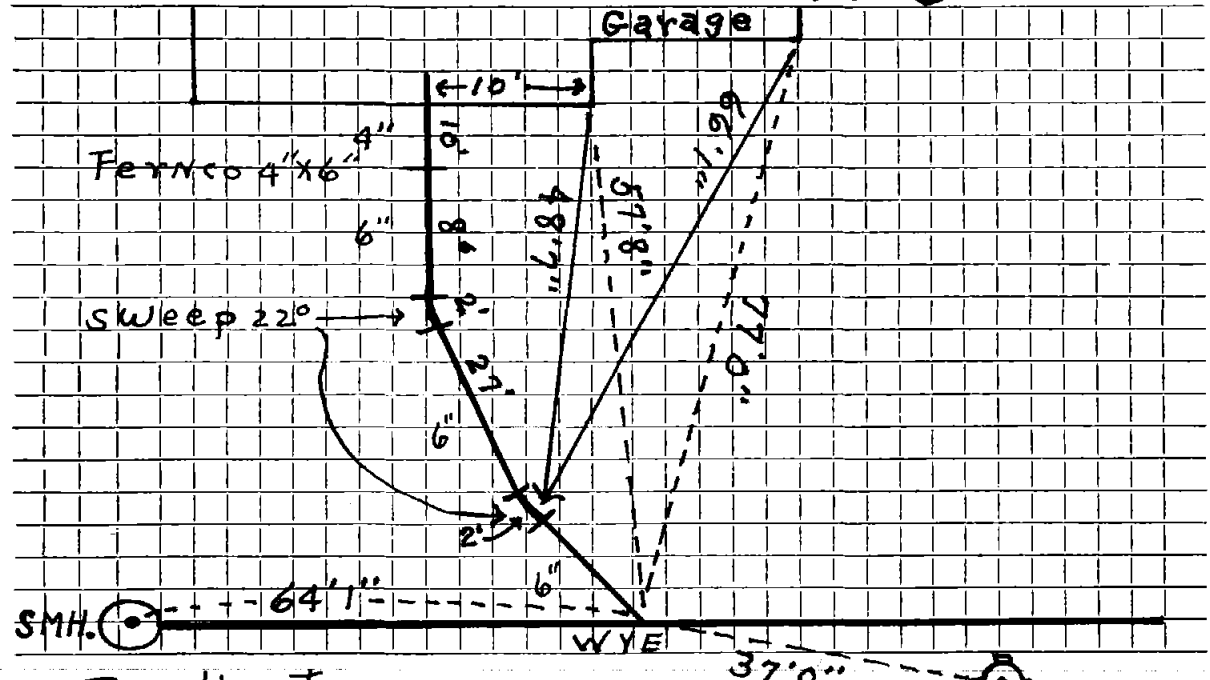

Connection made in Burlington Street. Work completed

Remarks: