

Name Agnes Clark

Service No. 138

Address 30 Burlington Street

Location

Kind of Pipe

Size

Size of Main

~~Repair-Renewal~~ New Service

W.O. #7576 - 400 # 7566


Location Comm 10-29-62

Date		Material	Amount	Total	Date		Amount
9-4-62		Labor	68.59		8-30-62	Deposit	350 00
9-5-62		"	21.08	89.67	10-29-62	Refund	117 41
		10% O.H.	8.97	98.64			232 59
	73'	6" Transite pipe @82		59.86			
	1	11 1/4" Transite Bend		4.09			
	4	Hrs. Town Shovel @6.50		26.00			
	3	Hrs. Trucking @3.00		9.00			
		35X3 Patch		35.00			
				232.59			

DATE _____

TOWN OF LEXINGTON — BOARD OF PUBLIC WORKS
SEWER DIVISION

Sketch of Service Here **30**

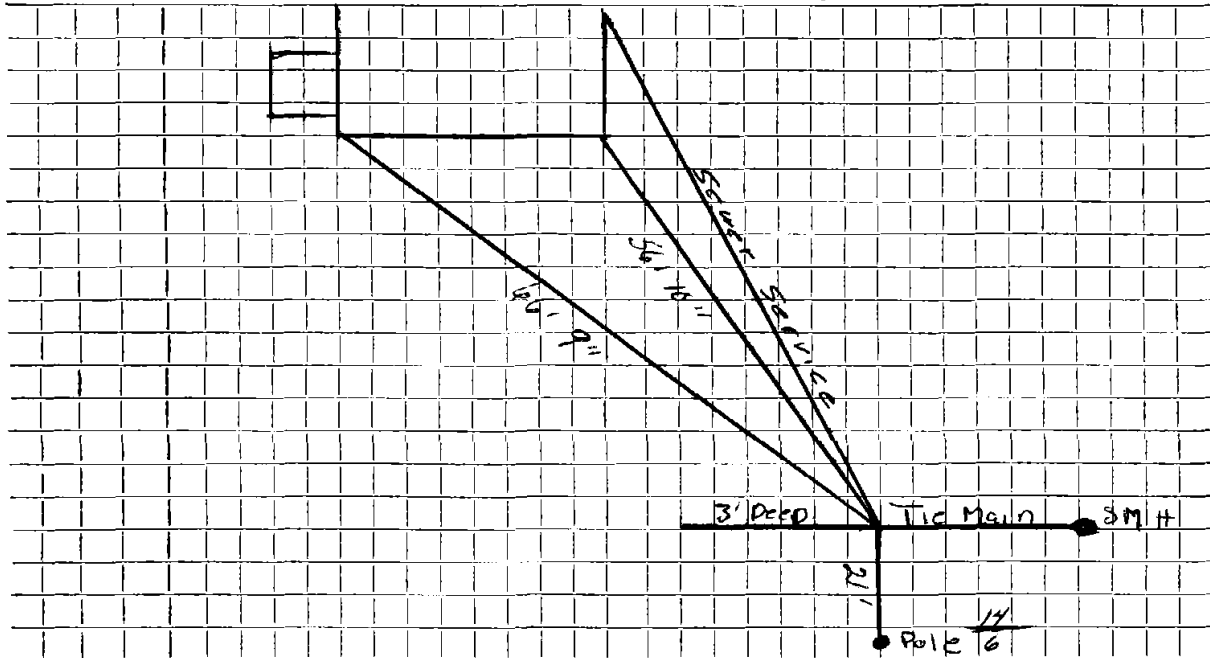

Connection made in Street. Work completed

Remarks:
.....
.....