

Name

Service No.

Address #38 BURLINGTON STREET

Location

Kind of Pipe

Size

Size of Main

Repair/Replacement - New Service

Location


Date	Material	Amount	Total	Date	Amount
8-30-62	Labor	38.78			
	105 C.H.	3.84	42.12		
	13 6" Transite pipe @.78		10.14		
	1 6 x 6 Y		4.09		
	2 hrs. Town Shovel @6.50		13.00		
	1 hr. Trucking @3.00		6.00		
	BILL WHEN CONNECTED		75.35		

DATE \_\_\_\_\_

TOWN OF LEXINGTON — BOARD OF PUBLIC WORKS  
SEWER DIVISION

Sketch of Service Here

38

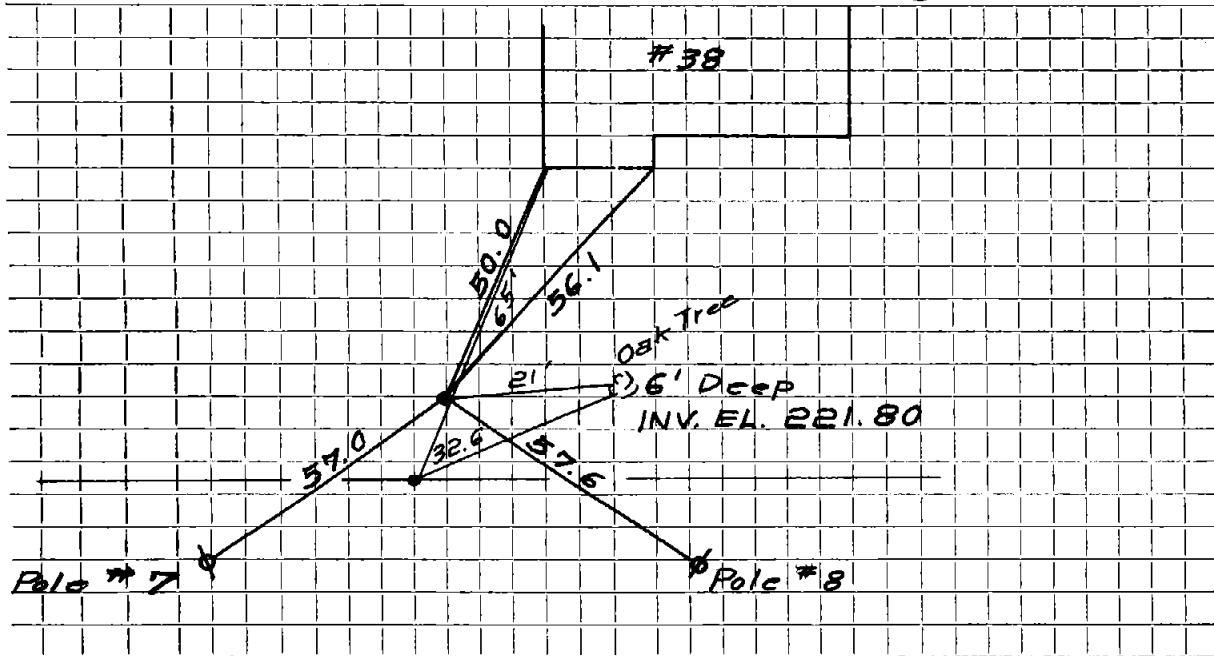

Connection made in ..... Street. Work completed .....

Remarks: .....

.....

.....