

Name Mrs. Helen Sizer

Service No. 21

Address 50 Burlington St.

Location

Lexington

Kind of Pipe

Size

Size of Main

~~Repair or Renewal~~ New Service COM. 4-6-53

Location

Date	Material	Amount	Total	Date	Amount
3/20/53	Labor	55 88		3-9-53	Deposited 175 --
	10% overhead	5 59	61 47	4-6-53	Refunded (46 14)
	6 1/2"-6" Sewer Pipe @.31/2		21 89		128 86
	1-6" Elbow		1 88		
	1-6 x 6 Y		1 28		
	Joint Compound		3 84		
	5 Hr. Town Shovel @5.00		25 00		
	2 Hr. Trucking		1 50		
	Patching 12 x 3		12 00		
			128 86		
	Labor				

**TOWN OF LEXINGTON—DEPT. OF PUBLIC WORKS
SEWER DIVISION**

DATE.....

NO.


The undersigned applies for the construction of a particular sewer connecting No.....
Street and hereby agrees to comply with the Rules and Regulations governing the construction and use of Particular
Sewers, as now or at any future time established by the Board of Selectmen.

Am't of estimate \$.....

Am't Paid \$.....

..... Owner

Sketch of Service Here

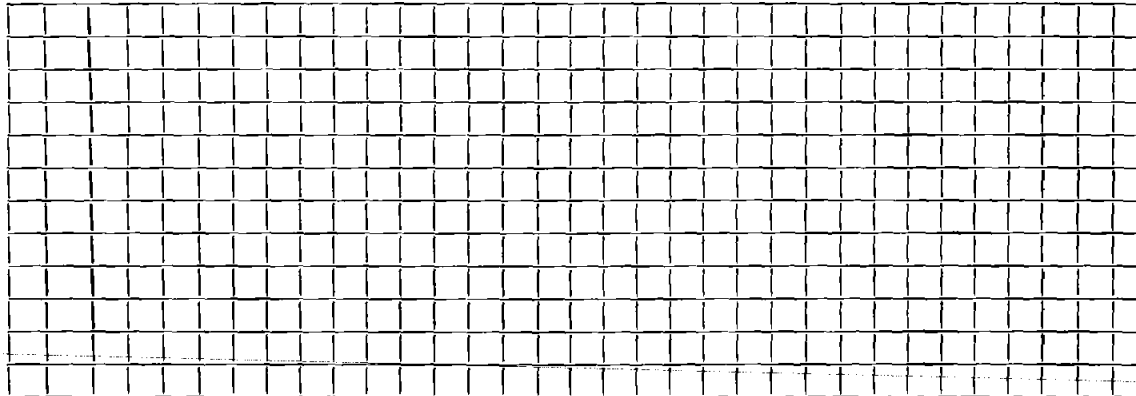

Connection made in..... Street.

Work completed.....19..

Remarks: