

Name **Warren Padelford & Mark Neubauer**

Service No. **125**

Address **#53 BURLINGTON STREET**

Lot #1

Location

Kind of Pipe

Size

Size of Main

~~Repair-Renewal~~ **New Service** **John E. Grant** Permit #67

Location *Comm 9-21-64*

Date	Material	Amount	Total	Date	Amount
9-10-62	Labor	75.79		<i>9-5-64</i>	<i>Deposit</i>
	10% O.H.	7.58	83.37		<i>141.40</i>
30'	6" Transite pipe @.82		24.60		
1	6" Transite End Cap		1.93		
3	hrs. Town Shovel @6.50		19.50		
2	hrs. Trucking @3.00		6.00		
2	hrs. Loader @3.00		6.00		
	BILL WHEN CONNECTED		141.40		
8-17-64	32' 6" Transite pipe				


DATE _____

TOWN OF LEXINGTON — BOARD OF PUBLIC WORKS

SEWER DIVISION

Sketch of Service Here

53

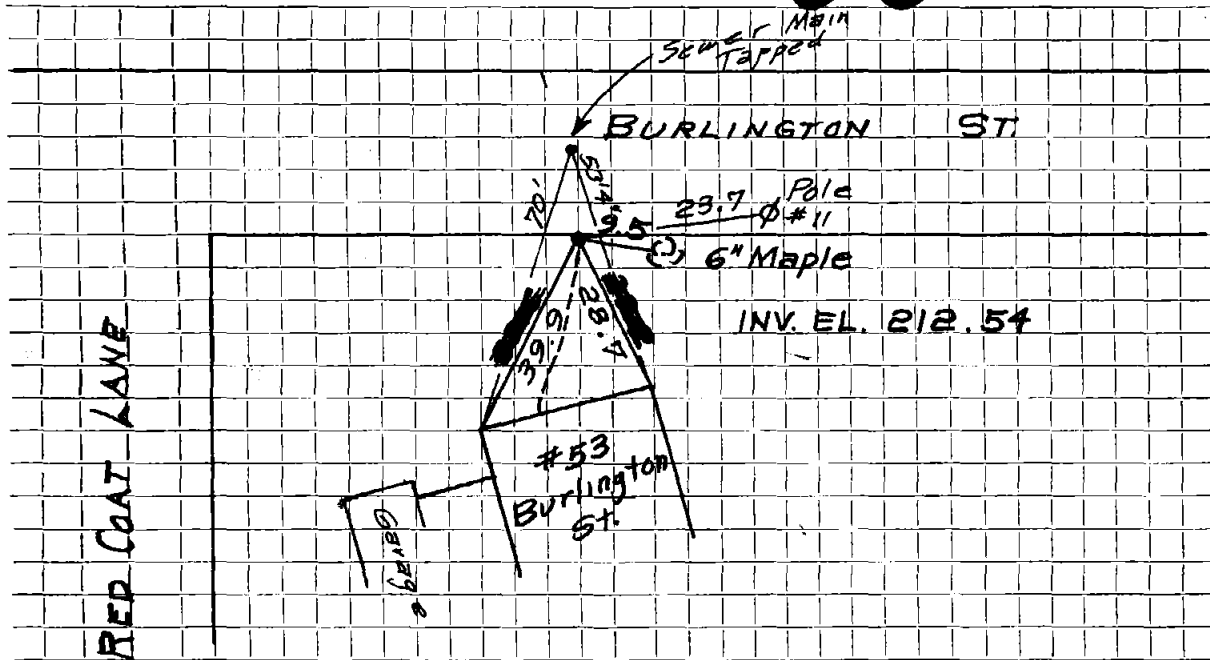

Connection made in Street. Work completed

Remarks:

.....

.....