

Name Milton KleinService No. 17Address 54 BURLINGTON ST.

Location

AUG 6 1979

Kind of Pipe

Size

Size of Main

~~Repair~~ ~~Renewal~~ ~~New Service~~

W.O. #0369

Location


| Date | Material | Amount | Total | Date | Amount |
|---------|----------------------|--------|--------|---------|-------------------|
| 6/28/79 | Labor \$165.92 | | | 4-23-79 | 356.00 |
| 6/29/79 | Labor 44.25 | 210.17 | | 9-11-79 | 100.51 |
| | 10% O.H. | 21.02 | 231.19 | | 456.51 |
| 30' | 6" Transite @ 1.91 | | 57.30 | 5-14-53 | New Service |
| 2 | 5' Nipples @ 2.33 | | 23.30 | 52' | 6" Sewer Pipe |
| 2 | 3' Nipples @ 9.36 | | 18.72 | 1 | 6"-1/8" Bend |
| 1 | 2' Nipple | | 7.60 | 1 | 6" Elbow |
| 1 | 6 X 6 Wye | | 11.89 | 1 | 6" X 6" Y |
| 1 | 1 1/4 Bend | | 9.52 | | |
| 1 | 2 1/2 Bend | | 14.12 | | |
| 1/2 | 1 1/4 Elbow | | 4.75 | | |
| 2 | 4" Donuts @ 3.05 | | 6.10 | | |
| 6 | Brick @ .12 | | .72 | | |
| 3 | Yds. Loam @ 5.44 | | 16.32 | | |
| 2 | Lbs. Seed @ .74 | | 1.48 | | |
| 3 | Hrs. Trucking @ 3.00 | | 9.00 | | |
| 6 | Hrs. Backhoe @ 6.50 | | 39.00 | | |
| | | | 450.51 | | |
| | | | | 3-22-79 | Roots 12'-16'-44' |
| | | | | 11-1-78 | Roots 12' + 44' |

DATE _____

TOWN OF LEXINGTON — BOARD OF PUBLIC WORKS
SEWER DIVISION

Sketch of Service Here

54

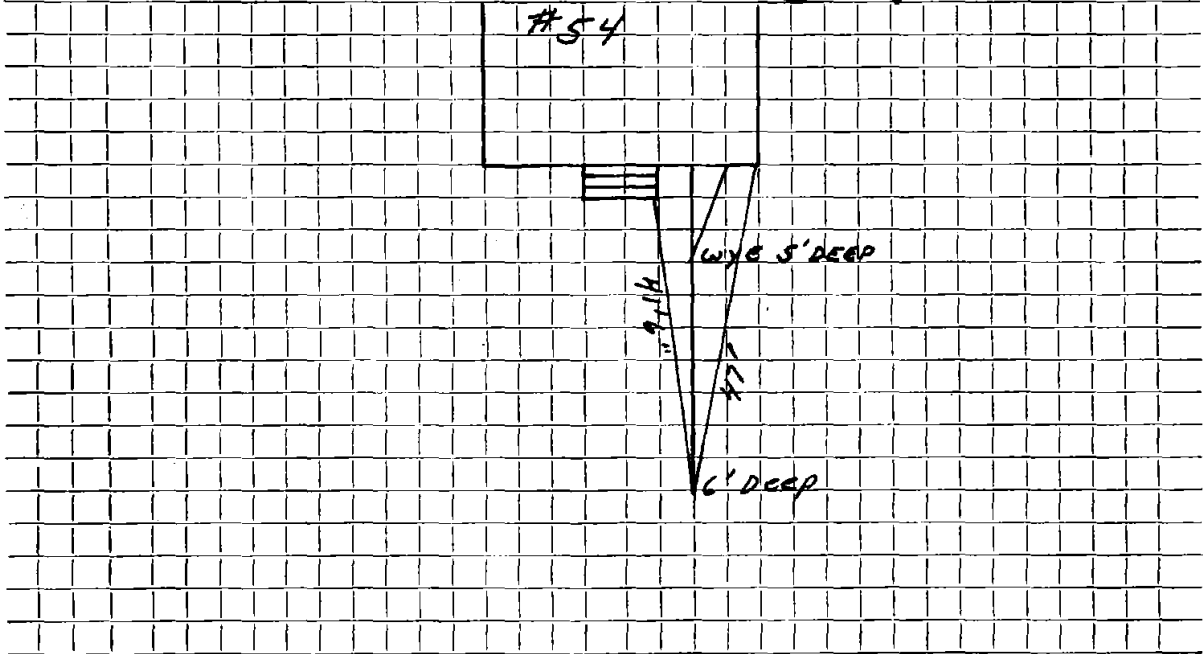

Connection made in Street. Work completed

Remarks:
.....
.....