

Name George Sullivan

Service No. 109

Address 60 Burlington St.,

Location

Kind of Pipe

Size

Size of Main

~~Repair or Renewal~~ New Service

Location Comm. 11-13-61


Date	Material	Amount	Total	Date	Amount
8/25/61	Labor	41 92		8-24-61	150 00
	10% O.H.	4 19	46 11	11-13-61	23 17
	44' 6" Transite Pipe @ .78		34 32		126 83
	1 6" 90° Transite Elbow		5 40		
	5 Hrs. Pippin Shovel @ 5.00		25 00		
	2 Hrs. Trucking @ 3.00		6 00		
	10 X 3 Patch		10 00		
			126 83		

DATE _____

TOWN OF LEXINGTON — BOARD OF PUBLIC WORKS
SEWER DIVISION

Sketch of Service Here

60

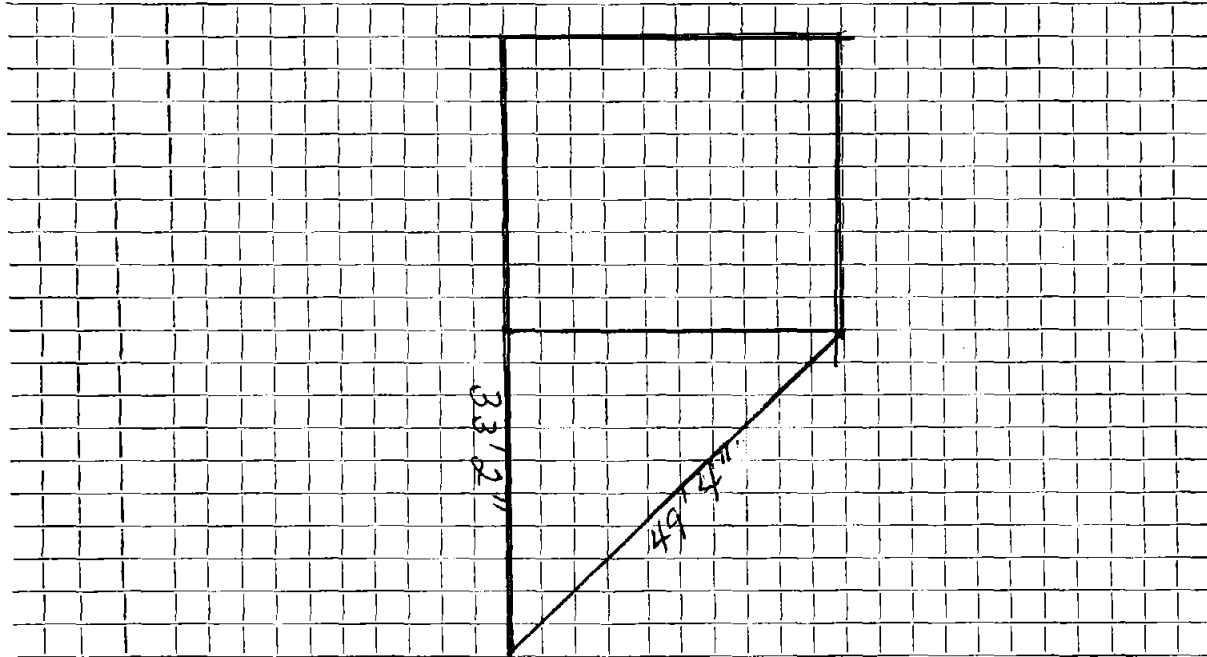

Connection made in Street. Work completed

Remarks:
.....
.....