

Name Raymond H. Whittaker

Service No. 29

Address 80 Burlington Street

Location

Kind of Pipe

Size

Size of Main

~~Maple Street~~ New Service W.O. #7850

Location Comm 5-27-63


Date	Material	Amount	Total	Date	Amount
4/29/63	Labor	12.26		4-19-63	250 00
4/30/63	"	94.00		6-14-63	33 41
5/3/63	"	24.52	130 72		283 41
	10 % O. H.	13 07	143 79		
	66' 6" Transite Pipe @ .82		54 12		
	1 11 1/2° Transite Elbow		2 35		
	16 X 8 Service Saddle		5 65		
	6 Yds Loam @ 3.00		18 00		
	3 Hrs. Town Shovel @ 6.50		19 50		
	4 Hrs. Trucking @ 3.00		12 00		
	1 Hr. Trailer @ 3.00		3 00		
	25 X 3 Patch		25 00		
			283 41		

DATE \_\_\_\_\_

TOWN OF LEXINGTON — BOARD OF PUBLIC WORKS  
SEWER DIVISION

Sketch of Service Here

80

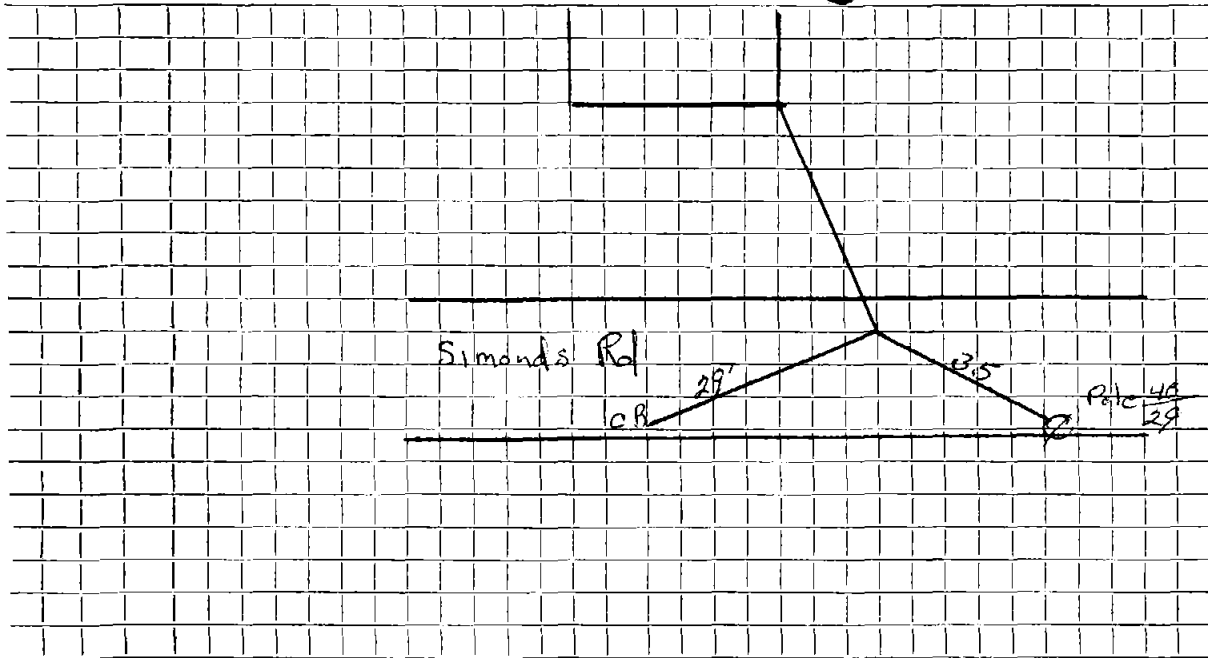

Connection made in ..... Street. Work completed .....

Remarks: ..Tap.. Main .. Wye .. N.C. .. S. Deep .....