


DATE 8/29/89

TOWN OF LEXINGTON — BOARD OF PUBLIC WORKS

SEWER DIVISION

Sketch of Service Here **9**

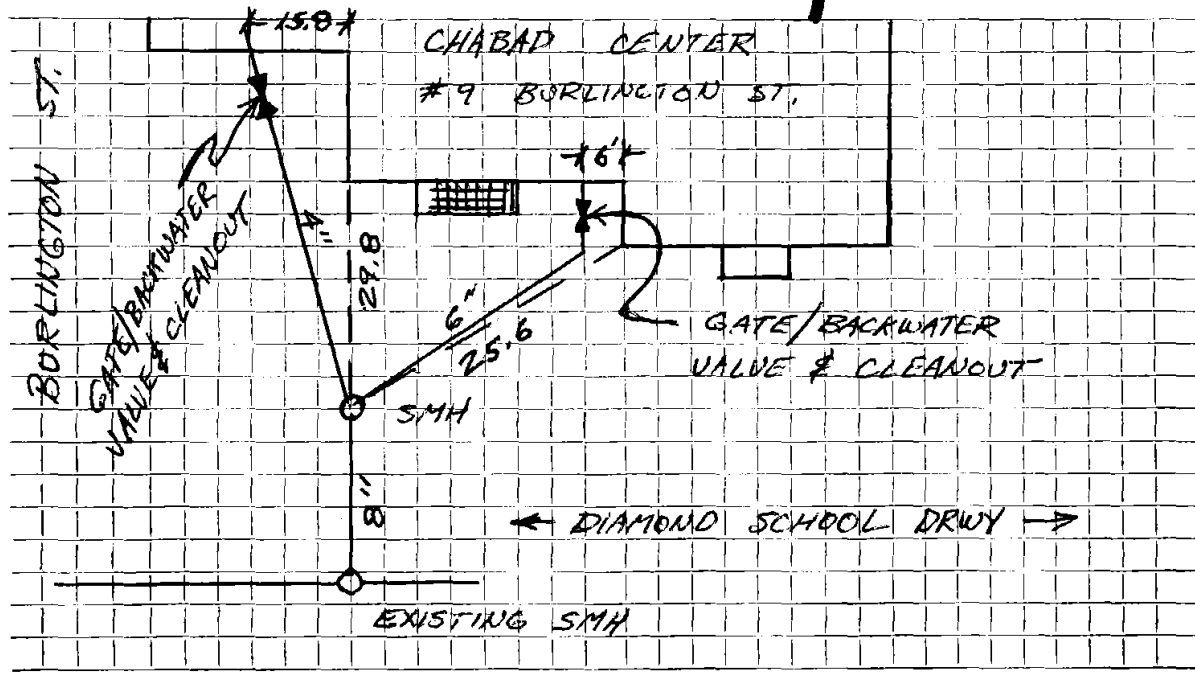

Connection made in SEWER EASEMENT 2 1/4" Street.

Work completed

Remarks: ...INSPE...CRG.....

Name Freeman Gray

Service No.

Address 9 Burlington Street

Lexington, Mass.

Location 9 Burlington Street

Kind of Pipe

Size

Size of Main

~~Repair~~ ~~Renewal~~ New Service

Com. 12-31-49

Location

Date	Material	Amount	Total	Date	Amount	
Dec. 13, '49	Labor	51 13		Dec 9 ' 49	150 00	
Dec. 14, '49	Labor	25 00	80 13	Dec 31 ' 49	6 96	
	10% Overhead		8 01		158 04	
	70' - 6" Sewer Pipe @.26		18 20	Dec. 14, '49	Labor	26 13
	Joint Compound		4 20	14' - 6" Sewer Pipe @.26		3 64
	Littlefield Shovel 6 hrs. @7.00	42 00	42 00	Joint Compound		84
	Trucking 2 hrs. @.75		1 50	Littlefield Shovel 3 hrs. @7.00	21 00	
	Patching 12 x 3		12 00	Trucking 1 hr. @.75	75	
			168 04	Patching 12 x 3	12 00	
					61 36	
	Labor					

