

Name Allan Jones

Service No. 43

Address 98 Burlington Street Lexington, Mass.

Location

Kind of Pipe

Size

Size of Main

~~Repair~~ ~~Renewal~~ New Service

WO #4601 ^{Grecia} ~~Eagle~~ #2840

Location

Date		Material	Amount	Total	Date		Amount
7/1/76		labor	130. 10		6-17-76	Deposit	300. 00
		10%Oh	13. 01	143. 11	8-16-76	Refund	37. 84
	10'	6" Transite Pipe @ 1.48		14. 80			262. 16
	1	5' X 6" Transite Nipple @ 1.56 ft.		7. 80			
	1	1' X 6" Transite Nipple		2. 44			
	1	6" X 6" Transite Nipple		1. 71			
	1	10" X 6" Iron Saddle		15. 07			
	1	ton coal patch		12. 50			
	1½	hr. truck @ 3.00		4. 50			
	2½	hr. shovel @ 6.50		16. 25			
		Patch 11 by 6		43. 98			
				262. 16			
7/2/76	25'	6" Transite Pipe					
	10'	4" Cast Iron Pipe					

**TOWN OF LEXINGTON—DEPT. OF PUBLIC WORKS
SEWER DIVISION**

DATE.....

NO.


The undersigned **applies** for the construction of a particular sewer connecting No.....
Street and hereby **agrees** to comply with the Rules and Regulations governing the construction and use of Particular
Sewers, as now or at any future time established by the Board of Selectmen.

Am't of estimate \$

Am't Paid \$

..... Owner

Sketch of Service Here

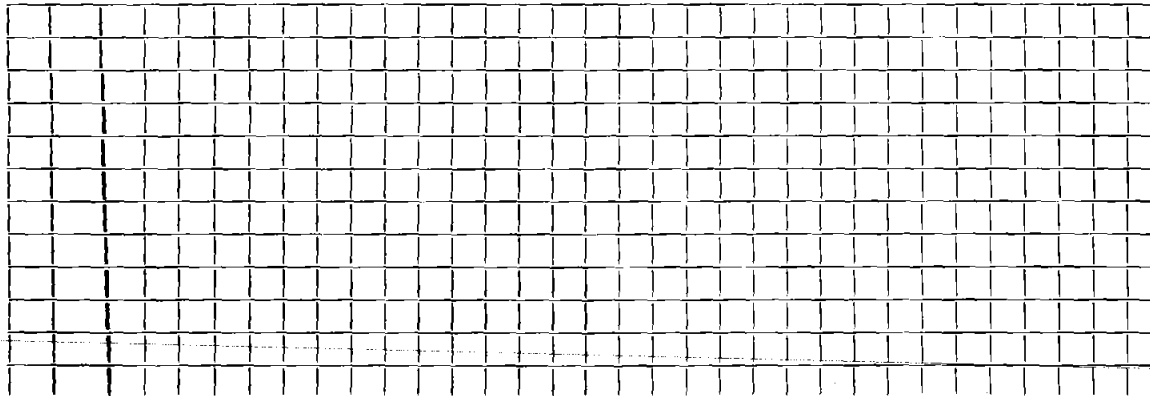

Connection made in Street.

Work completed 19..

Remarks: