


DATE 5/24/18

TOWN OF LEXINGTON — BOARD OF PUBLIC WORKS
SEWER DIVISION

Sketch of Service Here

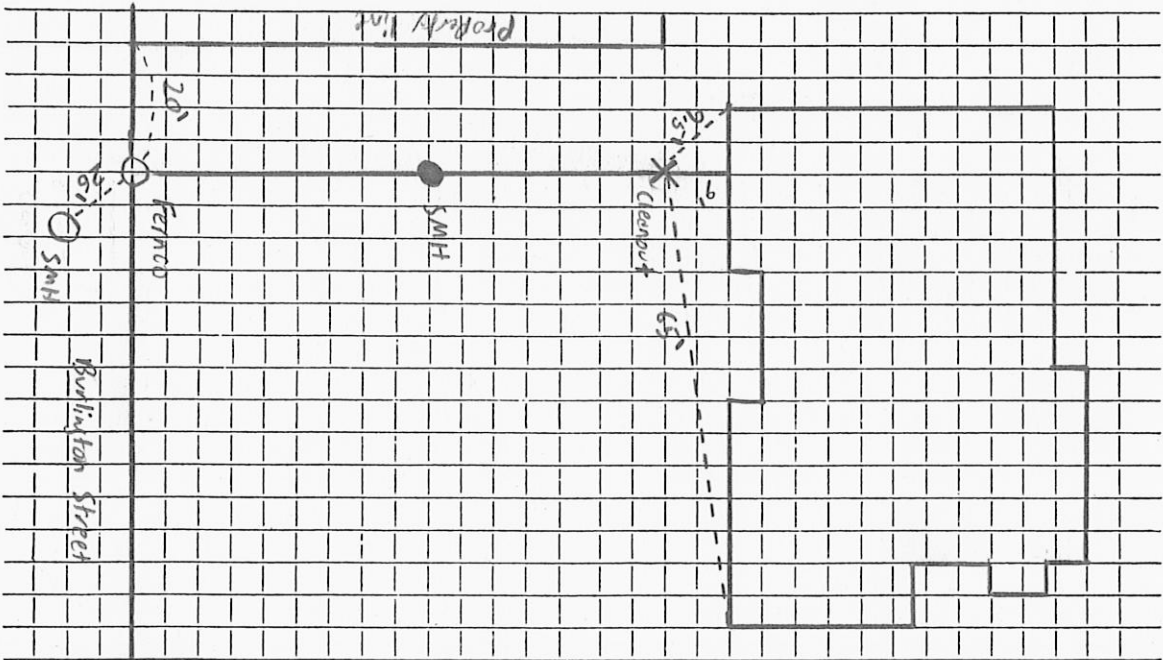

Connection made in Burlington Street. Work completed

Remarks: Depth is 10'

.....
.....