




DATE May 21, 2020

TOWN OF LEXINGTON — BOARD OF PUBLIC WORKS  
SEWER DIVISION

Sketch of Service Here

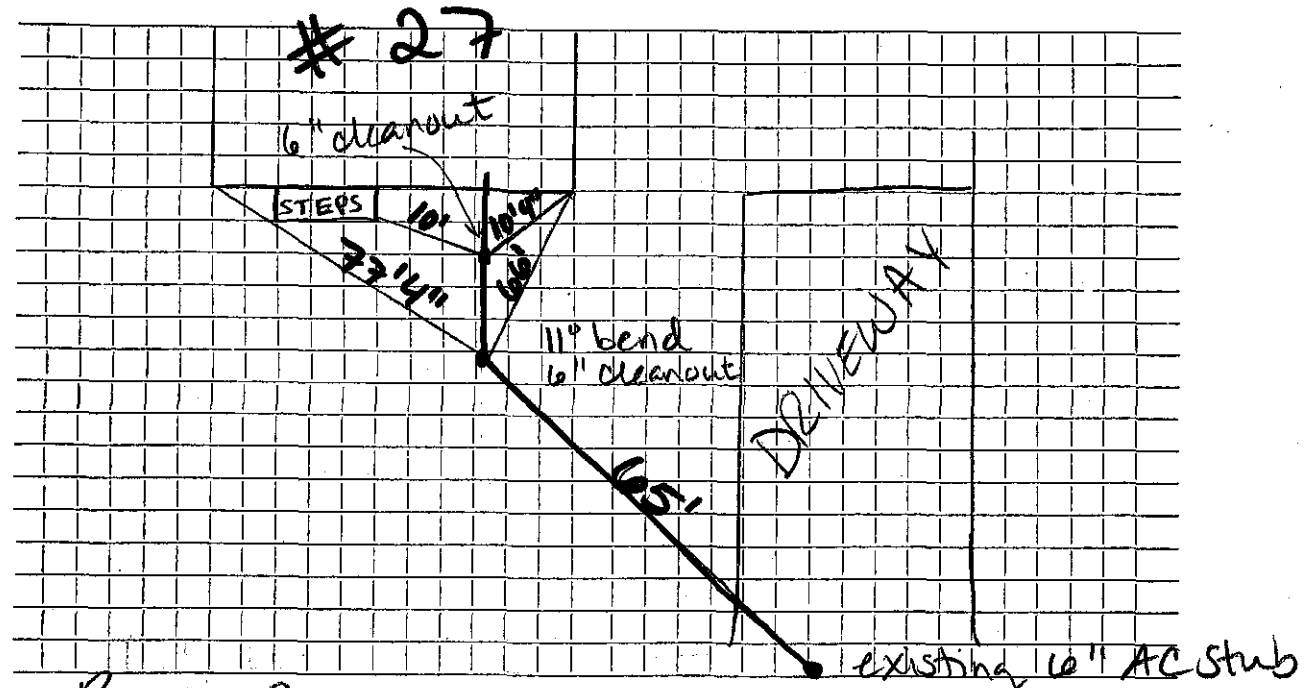

Connection made in Burlington Street. Work completed .....

Remarks: .....  
..... 1st cleanout from home is 10' away from foundation  
..... Depth at first cleanout closest to home = 4'      Depth at second cleanout is 5'6"