




DATE \_\_\_\_\_

TOWN OF LEXINGTON — BOARD OF PUBLIC WORKS  
SEWER DIVISION

Sketch of Service Here

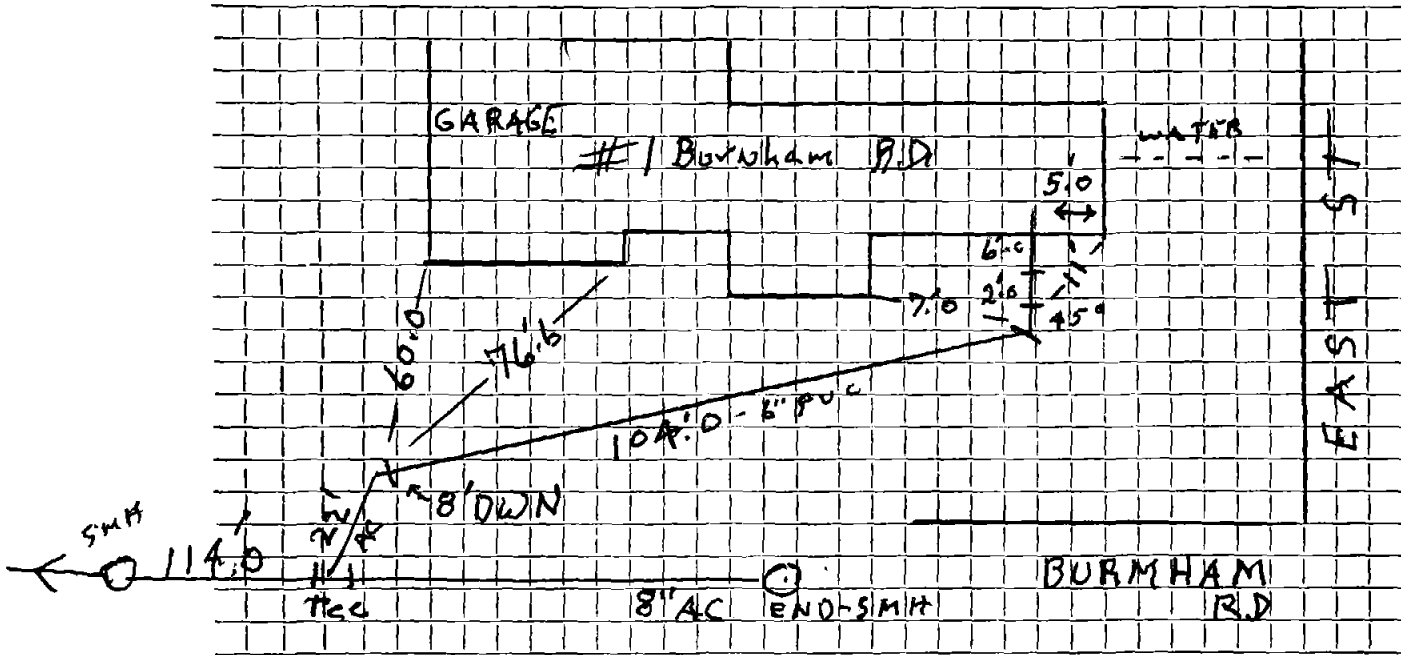

Connection made in Burmham RD Street. Work completed 1/9/06 J. McLaughlin

Remarks: 6" A C X PVC Franco w/ 45° bend