

Name Allan Kenney

Service No. 133

Address 10 Burnham Road

Location

Kind of Pipe

Size

Size of Main

Repair—Renewal—New Service Aldo #830

Location Comm 10-30-67

Date		Material	Amount		Total	Date		Amount
Oct 167	20	6" Transite pipe			120.00	10-10-67	<i>Deposit</i>	120.00
10-11-67	26	6" Transite pipe						
	10	4" Cast Iron pipe				10 - - 67		
						20'	6" Transite	


H.B.M.18501

DATE _____

TOWN OF LEXINGTON — BOARD OF PUBLIC WORKS

SEWER DIVISION

Sketch of Service Here **10**

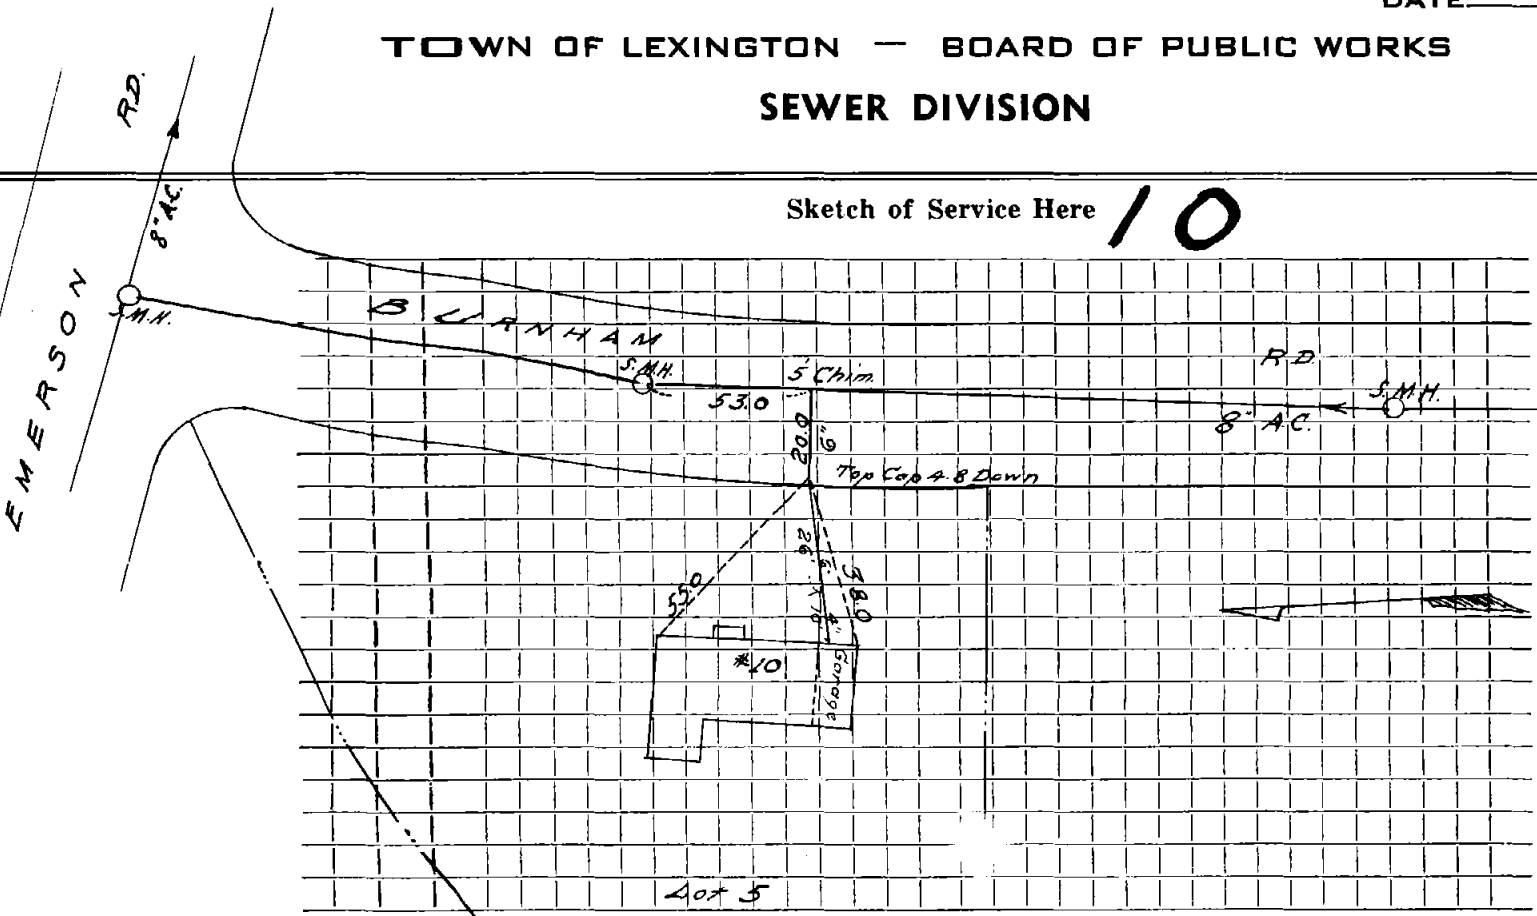

Connection made in Street. Work completed

Remarks:

.....

.....