




DATE \_\_\_\_\_

**TOWN OF LEXINGTON — BOARD OF PUBLIC WORKS**  
**SEWER DIVISION**

Sketch of Service Here

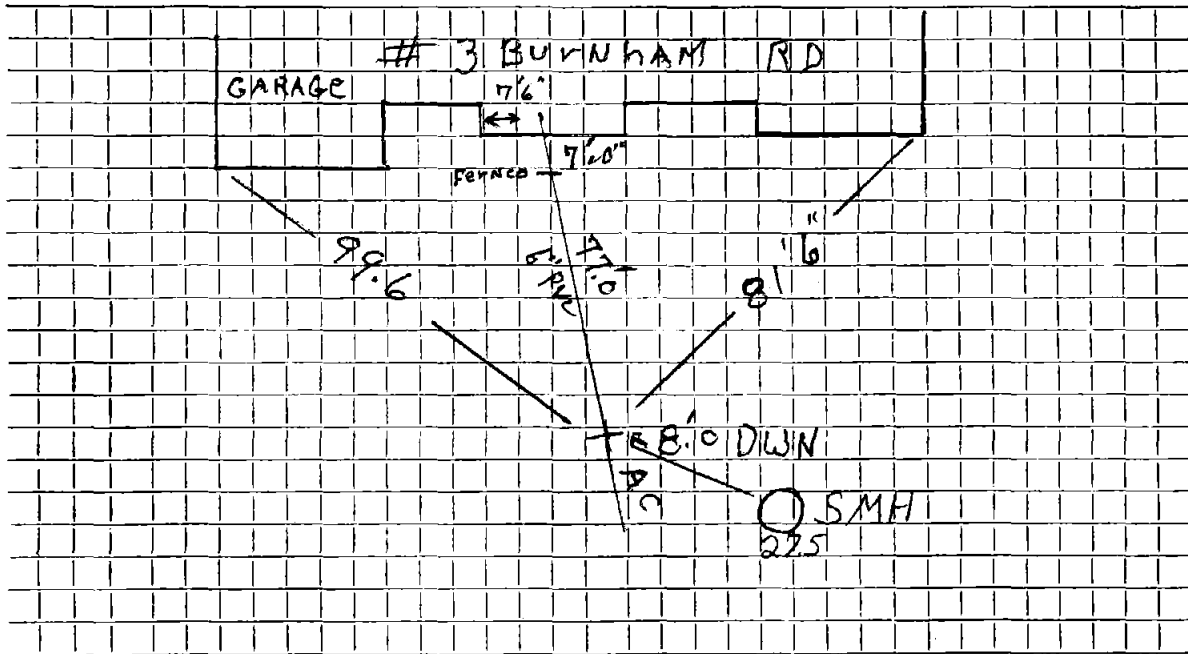

Connection made in ..... Street.

Work completed 8/2/05 J. McLaughlin

Remarks: .....  
.....  
.....